


WUTC DOCKET: TG-181023

EXHIBIT: DS-11X

ADMIT W/D REJECT

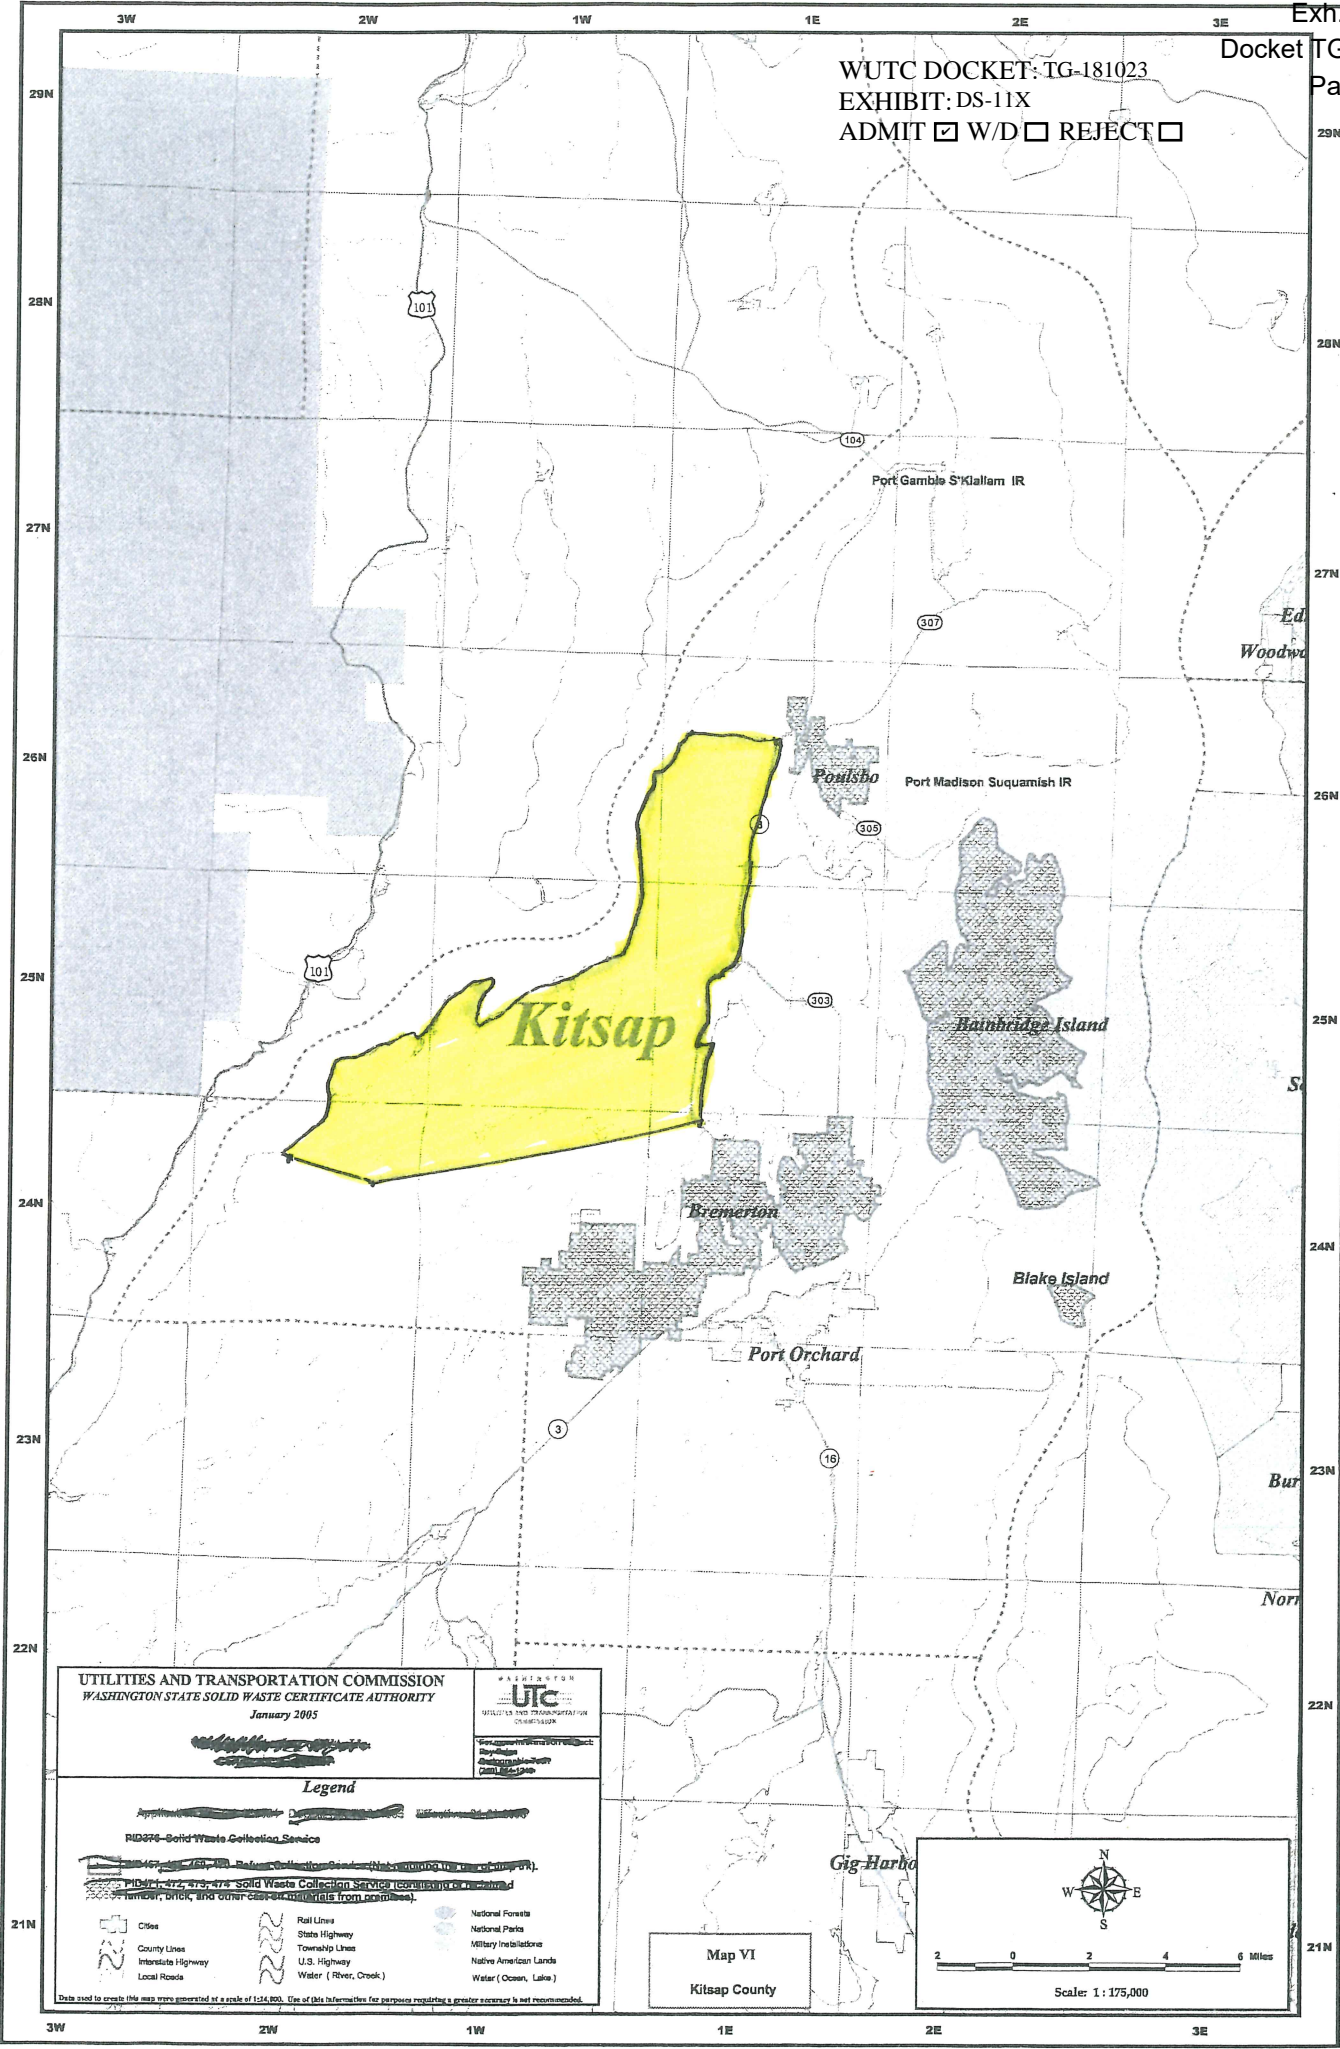

UTILITIES AND TRANSPORTATION COMMISSION
 WASHINGTON STATE SOLID WASTE CERTIFICATE AUTHORITY
 January 2005



Legend

~~Applicant's Proposed Service~~

~~RID276 Solid Waste Collection Service~~

~~WSDOT 472, 473, 474 Solid Waste Collection Service (concurrent with applicant's service)~~

~~Other Applicant's Proposed Service (not included in applicant's service)~~

Cities	Rail Lines	National Forests
County Lines	State Highway	National Parks
Interstate Highway	Township Lines	Military Installations
Local Roads	U.S. Highway	Native American Lands
	Water (River, Creek)	Water (Ocean, Lake)

Data used to create this map were generated at a scale of 1:24,000. Use of this information for purposes requiring a greater accuracy is not recommended.

Map VI
 Kitsap County

Scale: 1:175,000