



PG-051042

Rec. ctr
Pat J
File

RECEIVED
DISTRIBUTION CENTER

222 FAIRVIEW AVENUE NORTH SEATTLE, WASHINGTON 98109-5312 206-624-3900
FACSIMILE 206-624-7215

2005 JUL 5 AM 8:26
STATE OF WASH.
WUTC

July 5, 2005

David Lykken
Senior Pipeline Safety Engineer
Utilities and Transportation Commission
1300 S. Evergreen Park Drive SW
Olympia, WA 98504-7250

Subject: Request for written authorization under WAC 480-93-020

Dear Mr. Lykken:

This letter is a request for written authorization under WAC 480-93-020 for a proposed service at 9790 Padilla Heights Rd, in Anacortes, Skagit County. Our customer has requested service to this workshop building.

A plan drawing of the proposed service is attached. This service will tap Cascade's 16 inch March Point Transmission Line. This line has a maximum allowable operating pressure of 500 psig. 16 inch line was constructed in 1992.

The service building is currently 30 feet from our high pressure line easement. A ¾" steel service line will be extended 15 toward the building. A regulating device will be installed at that location, approximately 25 feet from the building, to reduce the pressure to 60 psig. We will install a second regulator and a meter at the customer's building to provide residential pressures.

Please have Staff contact me at your earliest convenience so I may provide whatever additional information is needed. Our customer has requested service as soon as possible.

Sincerely,
Cascade Natural Gas Corporation

Keith A. Meissner
Senior Pipeline Safety Engineer
(206) 381-6734

We make warm neighbors



FACILITIES INSTALLATION DIAGRAM

Requestor Name Norm's Excavation
Service Address 9790 Padilla Heights RD, Unit A
City, State, Zip Anacortes, WA 98221
Contact Phone 360-708-3730 360-293-1827


| | |
|------------|------------------------|
| W/O | Route Acct |
| W/R | Read Order |
| Estimate | Main Project/ER |
| Tax Parcel | Section Township Range |

| | | | |
|--|-----------------------|---|--|
| Service Type: <input type="checkbox"/> New Construction <input checked="" type="checkbox"/> Conversion <input type="checkbox"/> Multi <input type="checkbox"/> See Drawing Area | Bldg. / Dwelling Type | HPSS Required | If HPSS Required: |
| <input type="checkbox"/> New <input type="checkbox"/> Retire <input type="checkbox"/> Split <input type="checkbox"/> Mod Comp <input type="checkbox"/> Stub <input type="checkbox"/> Stub Comp | Commercial | <input checked="" type="checkbox"/> Yes <input type="checkbox"/> No | MAOP of HP Line |
| Pipe Size 5/8 | Pipe Type PE | Actual Footage | Test Pressure/Duration |
| Grid No. | Rate 504 | Class 2 | Pipe Condition <input type="checkbox"/> Good <input type="checkbox"/> Fair <input type="checkbox"/> Poor |
| Locate No. | Start Date: | Open Trench | Actual Trench Length |
| | Time: | <input type="checkbox"/> Yes <input type="checkbox"/> No | Split Service |
| Comments: | | <input type="checkbox"/> Yes <input checked="" type="checkbox"/> No | Route Acct of Cross Ref. |
| | | <input type="checkbox"/> Yes <input checked="" type="checkbox"/> No | Multi Meter |
| | | | Route Acct of Cross Ref. |
| | | | Variable (\$ / ft) \$13.61 |
| | | | Trench Credit (\$ / ft) |

I have identified to CNG any existing private utilities, sprinkler systems, drain fields, power service to other buildings or other known underground facilities. If this request is for the modification of an existing service line, I agree to pay for the modification at the hourly rate of \$265, plus material cost, if any, with a one (1) hour minimum paid in advance.

The undersigned property owner grants Cascade Natural Gas Corporation permission to install and maintain a gas service line across my property for the purpose of providing gas service to the neighboring property as shown on drawing below.

By: _____ Date: _____
 Print Name: _____
 Address: _____

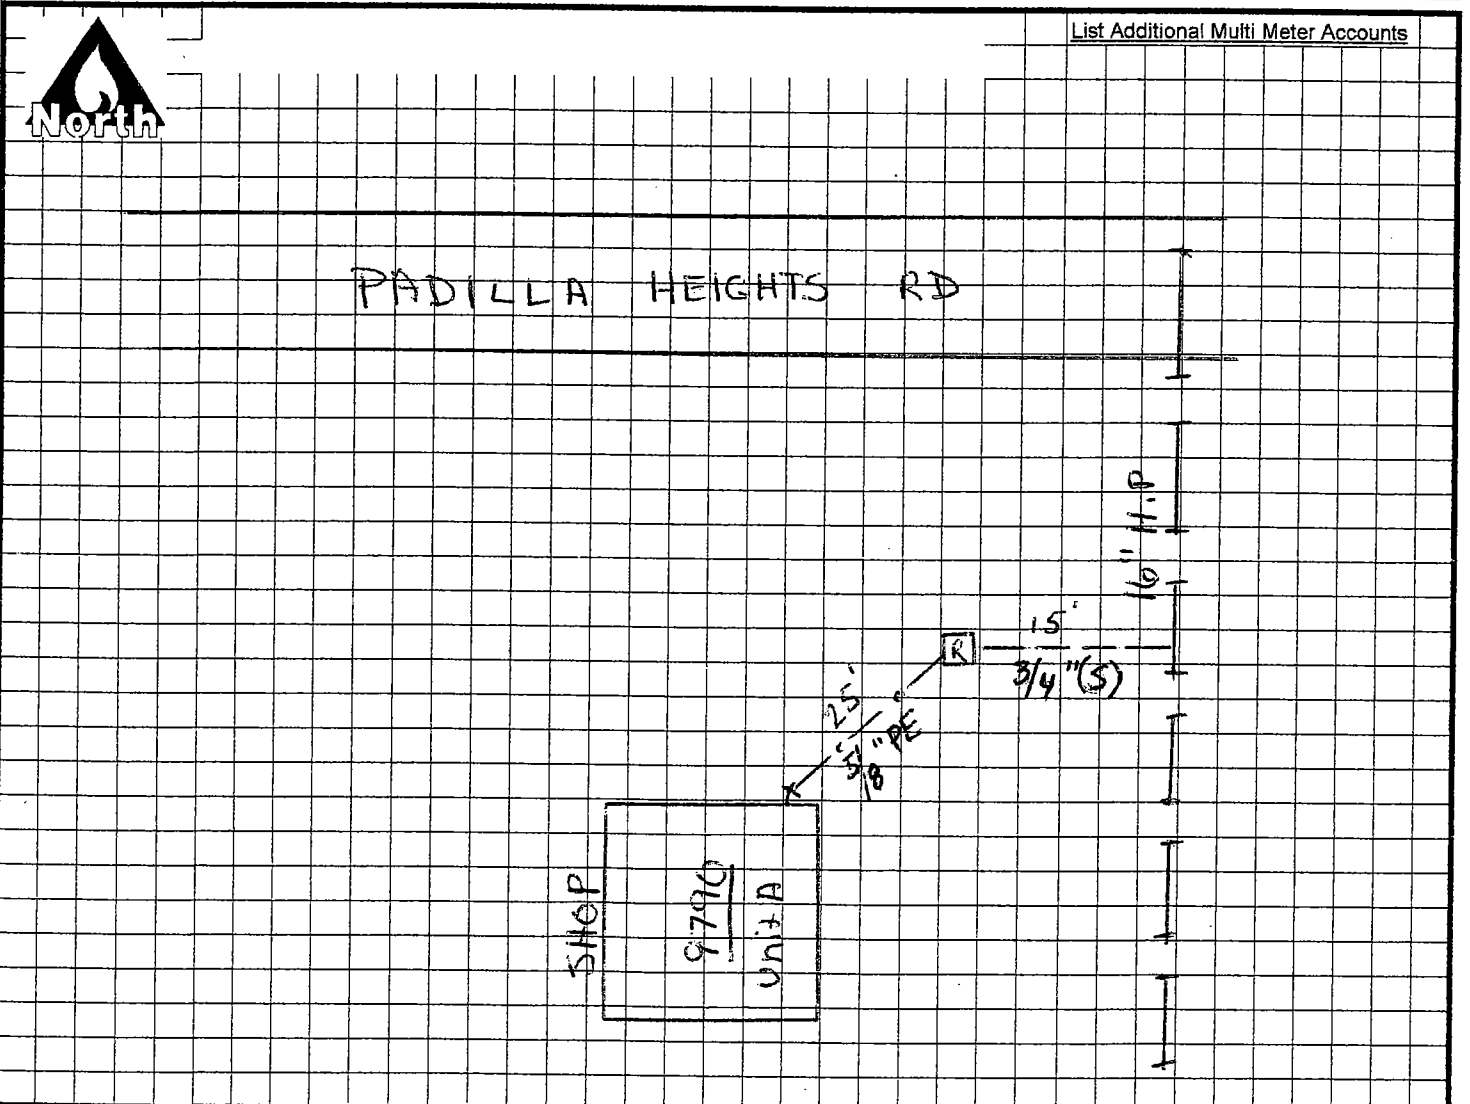

| | | | | | | |
|------------|------------|----------|------|---------|---------|----------|
| Materials: | WO Closed: | Premise: | CCC: | Posted: | Review: | Scanned: |
|------------|------------|----------|------|---------|---------|----------|