

WASHINGTON UTILITIES AND TRANSPORTATION COMMISSION

_____	)	DOCKET NO. TR-
	)	
Petitioner, City of Richland	)	PETITION TO MODIFY HIGHWAY-
	)	RAIL GRADE CROSSING ACTIVE
	)	WARNING DEVICES
vs.	)	
_____	)	USDOT CROSSING #      922-975L
Respondent, Tri-City and Olympia Railroad	)	
Company	)	UTC CROSSING #
	)	
.....	)	

The Petitioner asks the Washington Utilities and Transportation Commission to approve modification of highway-rail grade crossing warning signals.

*Section 1 – Petitioner’s Information*

Petitioner	City of Richland
Street Address	505 Swift Boulevard
City, State and Zip Code	Richland, WA 99352
Mailing Address, if different than the street address	P.O. Box 190, MS #26
Contact Person Name	Pete Rogalsky
Contact Phone Number and E-mail Address	509-942-7500, progalsky@ci.richland.wa.us

RECEIVED  
 2008 JUL 17 PM 4:45  
 WASHINGTON UTILITIES AND TRANSPORTATION COMMISSION

**Section 2 – Respondent's Information**

Respondent	Tri-City and Olympia Railroad Company
Street Address	2579 Stevens Drive
City, State and Zip Code	Richland, WA 99352
Mailing Address, if different than the street address	P.O. Box 1700
Contact Person Name	David L. Samples
Contact Phone Number and E-mail Address	509-371-8313, dlsamples@tcry.com

**Section 3 – Crossing Location**

1. Existing highway/roadway	Battelle Boulevard		
2. Existing railroad	Tri-City and Olympia Railroad Company		
3. USDOT Crossing No.	922-975L	UTC Crossing No.	
4. Located in the S.E. 1/4 of the S.E. 1/4 of Sec. 15		, Twp. 10 N.	, Range 28 E. W.M.
5. GPS location, if known			
6. Railroad mile post (nearest tenth)	36.3		
7. City	Richland, WA	County	Benton

**Section 4 – Current Highway Traffic Information**

1. Name of highway Battelle Boulevard

2. Road authority City of Richland

3. Average annual daily traffic (AADT) 976

4. Number of lanes 2

5. Roadway speed 35

6. Is the crossing part of an established truck route?      Yes \_\_\_\_\_ No X

7. If so, trucks are what percent of total daily traffic? \_\_\_\_\_

8. Is the crossing part of an established school bus route?      Yes \_\_\_\_\_ No X

9. If so, how many school buses travel over the crossing each day? \_\_\_\_\_

10. Describe any changes to the information in 1 through 7, above, expected within ten years:

\_\_\_\_\_  
\_\_\_\_\_  
\_\_\_\_\_

**Section 5 – Current Crossing Information**

1. Railroad company \_\_\_\_\_

2. Type of railroad at crossing     Common Carrier     Logging     Industrial  
 Passenger     Excursion

3. Type of tracks at crossing     Main Line     Siding or Spur

4. Number of tracks at crossing      1  

5. Average daily train traffic, freight      <1  

Authorized freight train speed   40      Operated freight train speed   25  

6. Average daily train traffic, passenger      0  

Authorized passenger train speed \_\_\_\_\_    Operated passenger train speed \_\_\_\_\_

7. Describe any changes to the information in 1 through 4, above, expected within ten years:

\_\_\_\_\_  
\_\_\_\_\_  
\_\_\_\_\_

8. What is the available sight distance from the stop bar (or 25 feet from the tracks if no stop bar) on both approaches to the crossing?

> 250 feet (Min. stopping sight distance for 35 mph design speed, AASHTO Geometric Design of Highways and Streets)

9. If the sight distance is less than 400 feet, describe the structures, roadway or track curvature, visual obstacles or other characteristics that limit sight distance.

\_\_\_\_\_  
\_\_\_\_\_





***Section 7 – Illustration of Proposed Warning Devices***

Attach a detailed diagram, drawing, map or other illustration showing the proposed warning devices.

**Section 8 - Waiver of Hearing by Respondent**

**Waiver of Hearing**

The undersigned represents the Respondent in the petition to modify highway-rail grade crossing warning signals at the following crossing.


USDOT Crossing No. 922-975L UTC Crossing No. \_\_\_\_\_

We have investigated the conditions at the crossing. We are satisfied the conditions are the same as described by the Petitioner in this docket. We agree the warning signals should be installed and consent to a decision by the commission without a hearing.

Dated at KENNEWICK, Washington, on the 14<sup>TH</sup> day of JULY, 2008.

DAVID L. SAMPLES

Printed name of Respondent

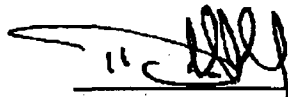

Signature of Respondent's Representative

DIRECTOR, GOVERNMENTAL AFFAIRS

Title

509-727-8851 / DLSAMPLES@TCRY.COM

Phone number and e-mail address


TRI-CITY/OLYMPIA RAILROAD COMPANY  
10 NORTH WASHINGTON STREET  
KENNEWICK, WA 99336

Mailing address



1 2 3 4 5 6 7 8

A B C D E F

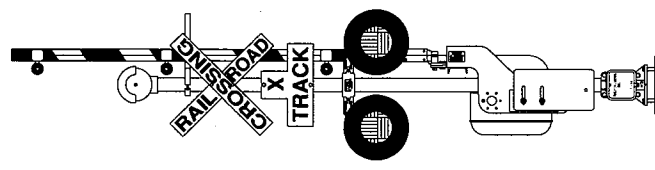

# TRI-CITIES & OLYMPIA RAILROAD


## BATTELLE BLVD, DOT # 922 975L

### RICHLAND, WASHINGTON

M.P. 36.3

#### PRELIMINARY DRAWINGS

THE OPERATION OF THE CIRCUITS AND EQUIPMENT REPRESENTED CANNOT BE FINALLY CHECKED UNTIL CONNECTED TO FORM A COMPLETE SYSTEM OR PORTION OF SUCH A SYSTEM. SUCH A SYSTEM OR PORTION OF SUCH A SYSTEM MUST UNDERGO A COMPLETE CIRCUIT CONTACT SELECTION (BREAKDOWN) AND SERVICE (OPERATION) TEST PRIOR TO BEING PLACED INTO REGULAR SERVICE.

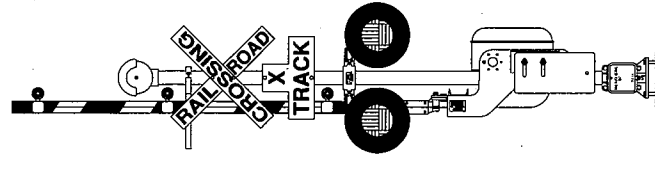


SHT#	SHEET DESCRIPTION	SHT#	SHEET DESCRIPTION
1	COVER SHEET	9	SEAR II EVENT RECORDER
2	CROSSING LAYOUT	10	RTU CIRCUIT
3	CABLE LAYOUT	11	POWER DISTRIBUTION
4	TYPICAL SIGNAL DETAIL	12	HOUSE LAYOUT
5	GCP 3000 CIRCUIT	13	HOUSE LAYOUT DETAILS
6	SSCC IIIA CIRCUIT	14	TYPICAL TRACK CONNECTION
7	SIGNAL GATE "L" CIRCUIT	15	GCP3000 HISTORY CARD
8	SIGNAL GATE "R" CIRCUIT		

SHT#	SHEET DESCRIPTION	SHT#	SHEET DESCRIPTION
1	COVER SHEET	9	#2 SSCC IIIA CIRCUIT
2	CROSSING LAYOUT	10	SIGNAL GATE "M" CIRCUIT
3	CABLE LAYOUT	11	SEAR II EVENT RECORDER
4	TYPICAL SIGNAL DETAIL	12	RTU CIRCUIT
5	GCP 3000 CIRCUIT	13	POWER DISTRIBUTION
6	#1 SSCC IIIA CIRCUIT	14	HOUSE LAYOUT
7	SIGNAL GATE "L" CIRCUIT	15	HOUSE LAYOUT DETAILS
8	SIGNAL GATE "R" CIRCUIT	16	TYPICAL TRACK CONNECTION

RED = IN YELLOW = OUT

NO.	REVISION	BY	DATE	APPD

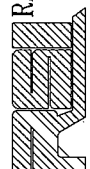



**RAILROAD SIGNAL INTERNATIONAL**  
 PHONE: (800) 543-2842 FAX: (918) 234-1529  
 TULSA, OKLAHOMA  
[WWW.RAILROADSIGNALINC.COM](http://WWW.RAILROADSIGNALINC.COM)

**TRI-CITIES & OLYMPIA RAILROAD**  
 RICHLAND, WA

PROJECT NUMBER: 922975L  
 SHEET: 23-05-RCR  
 DATE: 01 OF 17  
 C. Harris

PROJECT: HIGHWAY RAILROAD GORGE CROSSING WARNING SYSTEM  
 DRAWN BY: M. Castro  
 DATE: 05/05/2005  
 REV. 23-05-S01

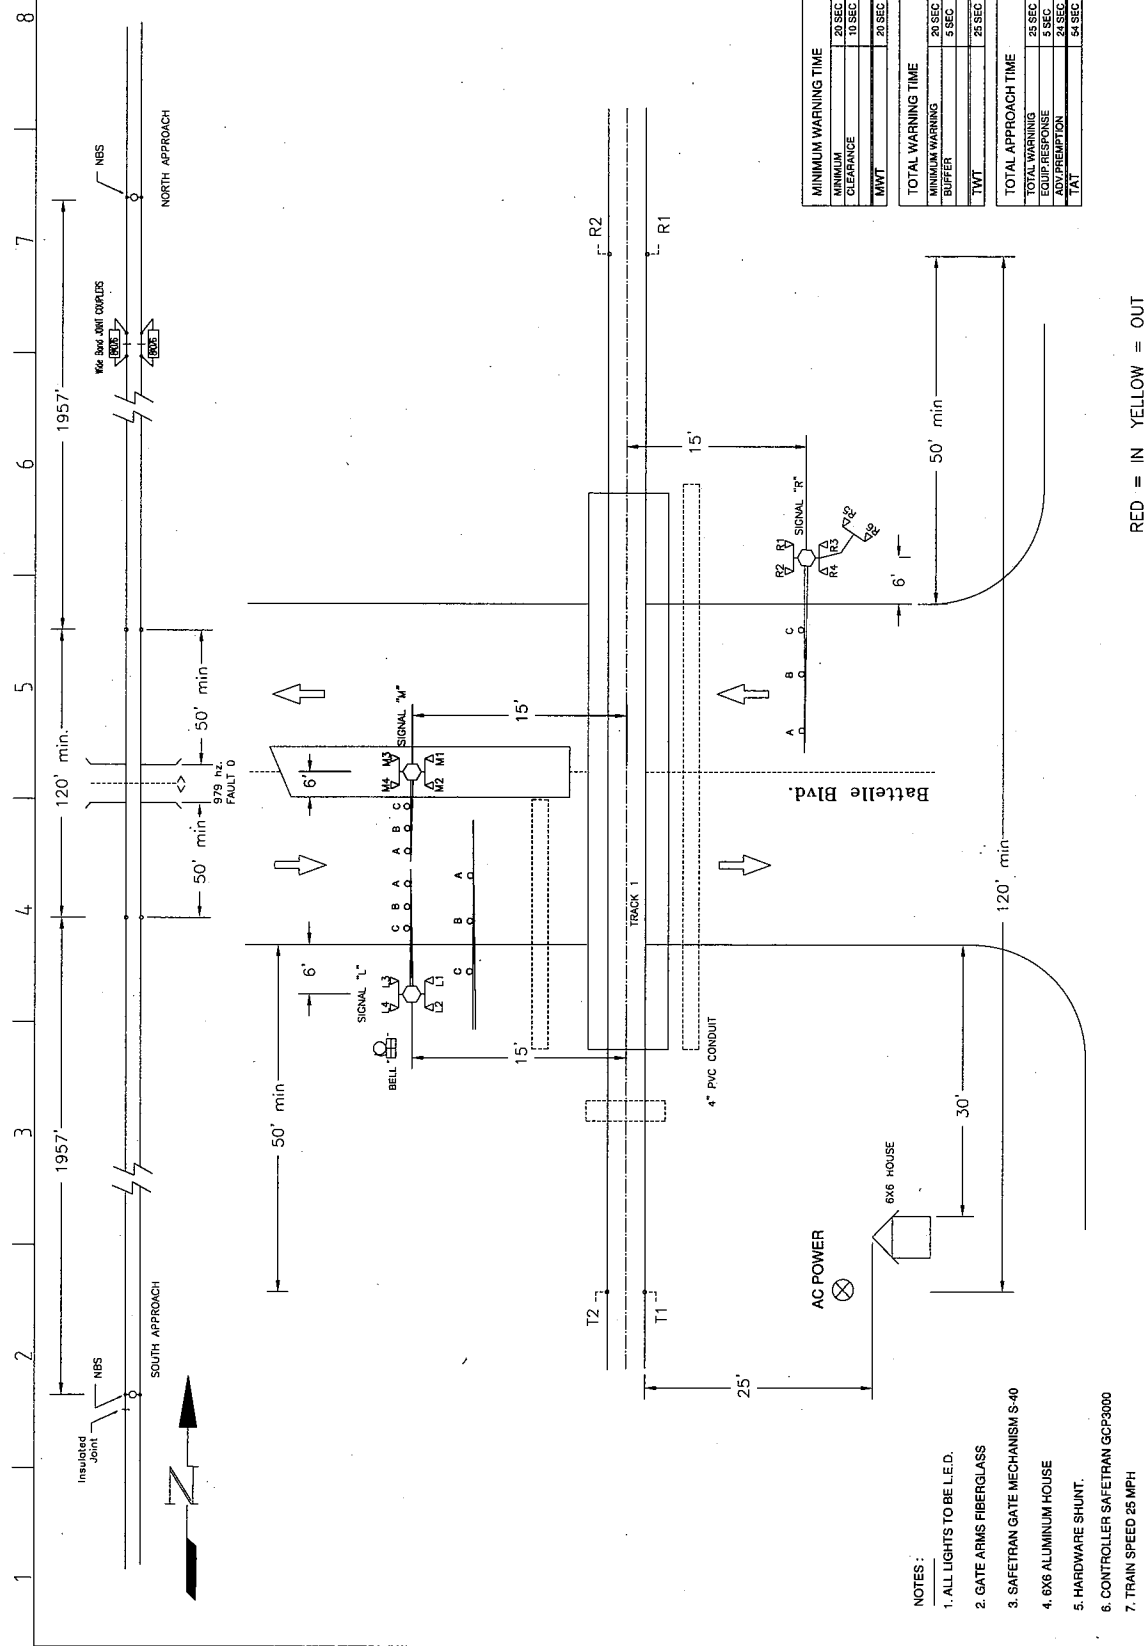

MINIMUM WARNING TIME	
MINIMUM	20 SEC
CLEARANCE	10 SEC
HWYT	20 SEC

TOTAL WARNING TIME	
MINIMUM WARNING	20 SEC
BUFFER	5 SEC
TWT	25 SEC

TOTAL APPROACH TIME	
TOTAL WARNING	25 SEC
EQUIP RESPONSE	5 SEC
ADVANCEMENT	24 SEC
TAT	54 SEC

- NOTES:
1. ALL LIGHTS TO BE I.E.D.
  2. GATE ARMS FIBERGLASS
  3. SAFETRAN GATE MECHANISM S-40
  4. 6X6 ALUMINUM HOUSE
  5. HARDWARE SHUNT.
  6. CONTROLLER SAFETRAN GCP3000
  7. TRAIN SPEED 25 MPH

RED = IN YELLOW = OUT

NO.	REVISION	BY	DATE	APPD
1	ADD MEDIAN GATE "M"	ACE	4/1/08	

DOT NUMBER	9229751
PROJECT NO.	23-05-RICH
PROJECT APPROVED BY	E. DUBINS
DATE	02 OF 17
REV.	23-05-S02


**RAILROAD SIGNAL INTERNATIONAL**  
 PHONE: (800) 543-7842 FAX: (918) 234-1529  
 TULSA, OKLAHOMA  
 WWW.RAILROADSIGNALINC.COM

**TRI-CITIES & OLYMPIA RAILROAD**  
 BATTELLE BLVD.  
 RICHLAND, WA

CROSSING LAYOUT  
 HIGHWAY RAILROAD GRADE CROSSING WARNING SYSTEM  
 DRAWN BY: DATE: DWG  
 A.R. 03/29/2006 02 OF 17 HCL  
 7 02 OF 15 8

UG CABLES DESCRIPTION	
1	2C#6 AWG TWISTED PAIR
2	2C#6 AWG TWISTED PAIR
3	1 ea 5C#6 AWG & 1 ea 7C#9 AWG
4	1 ea 5C#6 AWG & 1 ea 7C#9 AWG
5	3 ea 1C#8 AWG - 600 Volt Rated
6	1 ea 5C#6 AWG & 1 ea 7C#9 AWG
7	
8	
9	
10	

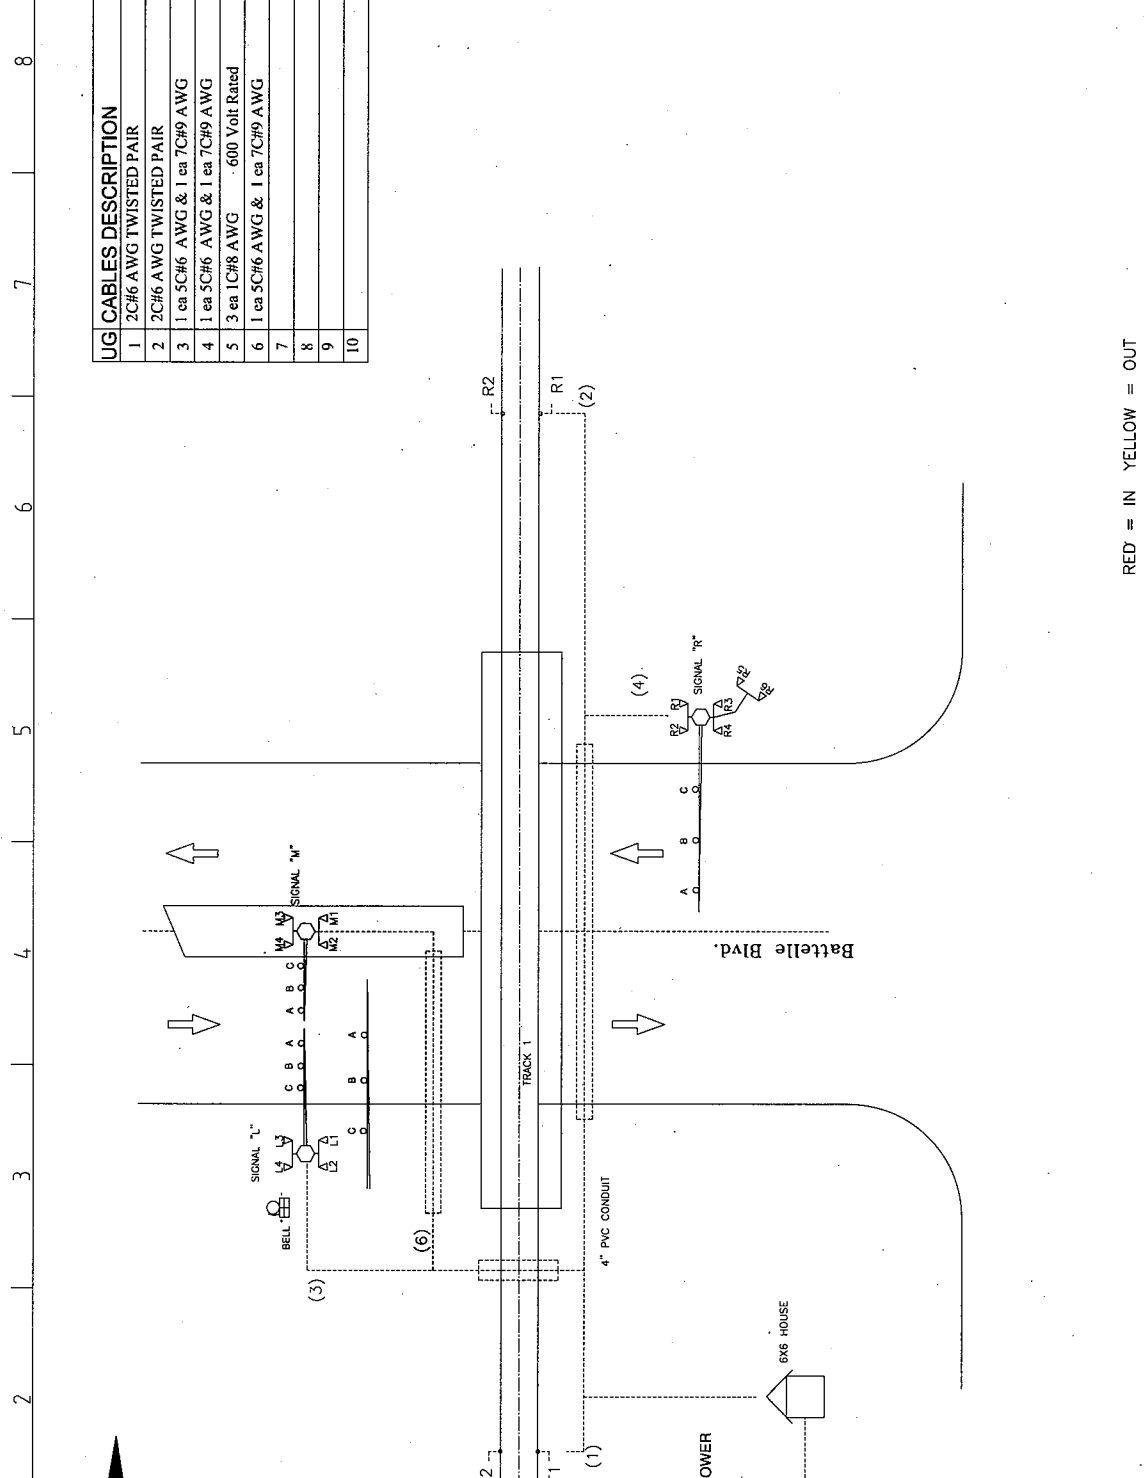


RED = IN YELLOW = OUT

<b>RAILROAD SIGNAL INTERNATIONAL</b> PHONE: (800) 543-7842 FAX: (918) 234-1529 TULSA, OKLAHOMA WWW.RAILROADSIGNALINC.COM		<b>TRI-CITIES &amp; OLYMPIA RAILROAD</b> RICHMOND, WA	
DOT NUMBER 922975L	PROJECT No. 23-05-RICH	DRAWN BY E. Blum	DATE 06/26/06
TCS 4/1/06	ACE	REVISION BY DATE APPD	SHEET NO. 23-05-s03
NO. 1	ADD MEDIAN GATE "M"	NO. 2	NO. 3
NO. 4	NO. 5	NO. 6	NO. 7
NO. 8	NO. 9	NO. 10	NO. 11

HIGHWAY RAILROAD GRADE CROSSING WARNING SYSTEM  
 DATE: 06/26/06 (3 OF 17) PGS  
 23-05-s03  
 RICHMOND, WA

1 2 3 4 5 6 7 8

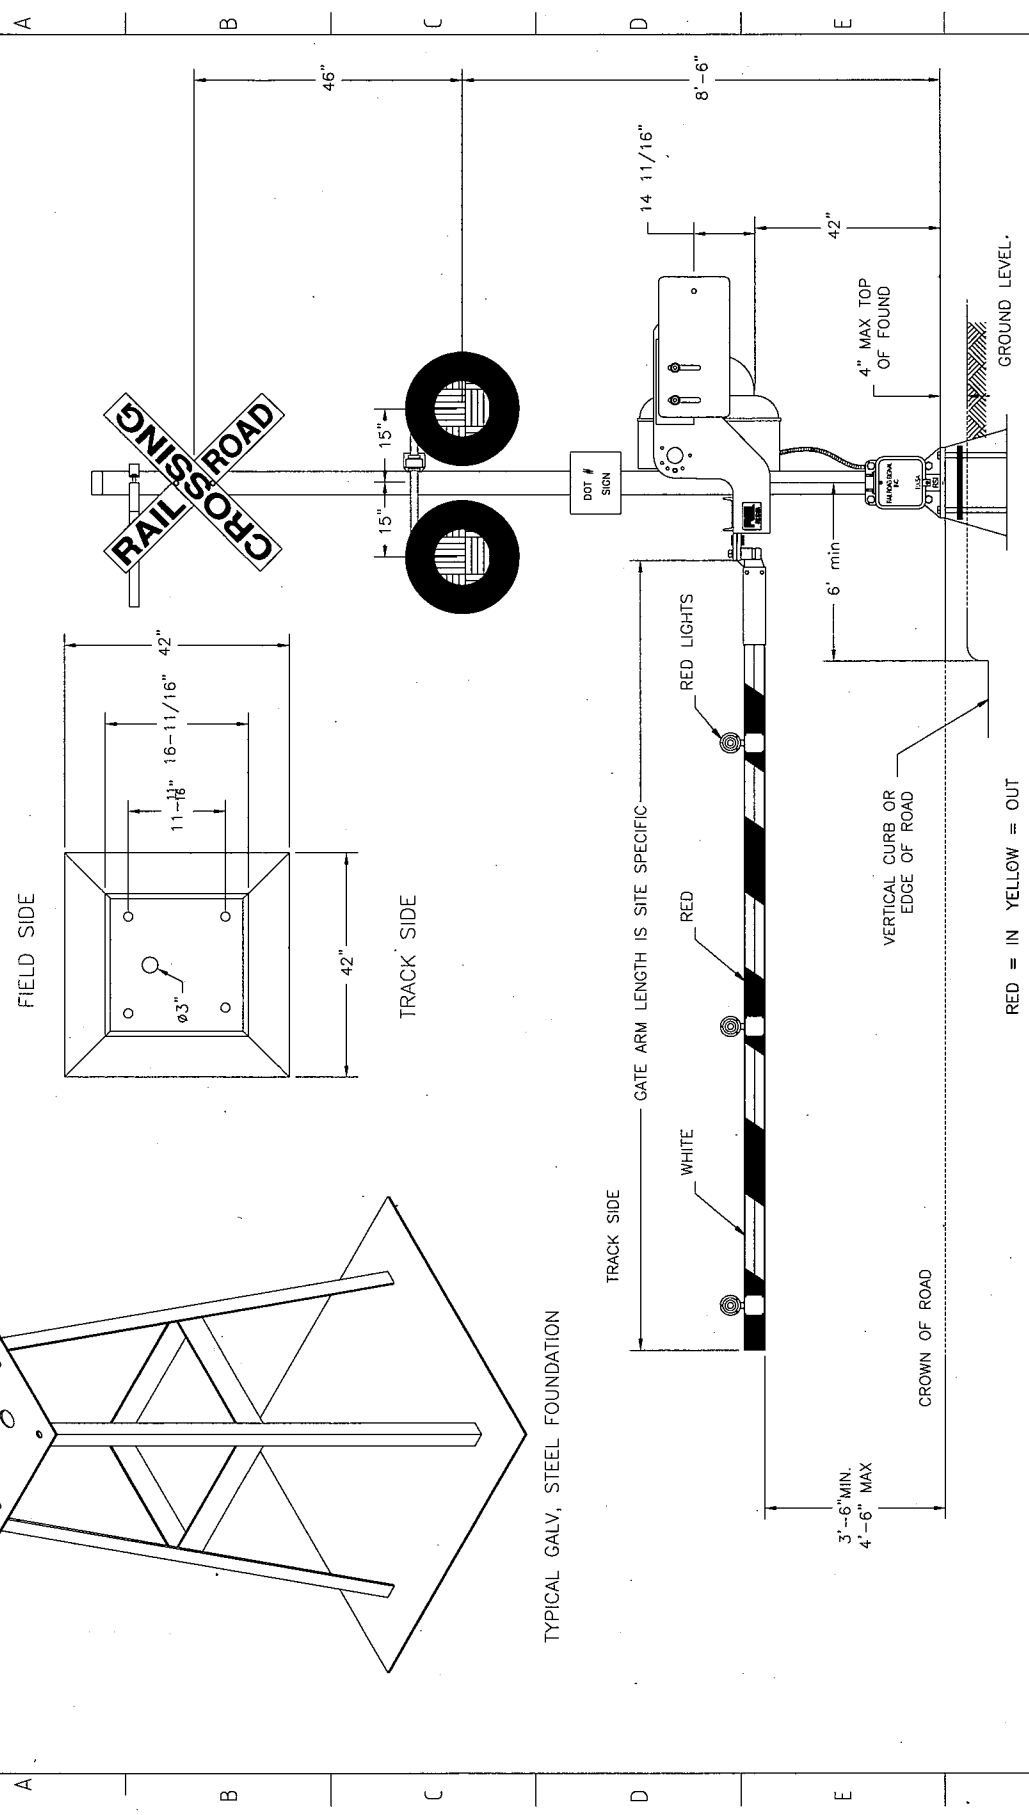

NO.	REVISION	BY	DATE	APPD
1			3	
TCS 4/1/08 ACE				
1. ADD MEDIAN GATE "M"				

**RAILROAD SIGNAL INTERNATIONAL**  
 PHONE: (800) 543-2842 FAX: (918) 234-1529  
 TULSA, OKLAHOMA  
 WWW.RAILROADSIGNALINC.COM

**TRI-CITIES & OLYMPIA RAILROAD**  
 DOT NUMBER: 922875L  
 PROJECT NUMBER: 23-05-S04  
 DRAWN BY: M. COITTO  
 CHECKED BY: M. COITTO  
 DATE: 05/06/2005  
 TIME: 04 OF 15

BATTLE BLVD. RICHLAND, WA  
 TYPICAL SIGNAL DETAIL  
 HIGHWAY RAILROAD GRADE CROSSING WARNING SYSTEM  
 RICHLAND, WA  
 23-05-S04  
 8

# PROGRAM INFORMATION


## OPTION ADJUSTMENTS

IND.	PARAMETER	DEFAULT VALUE	SET UP VALUES
1	NUMBER OF TRACKS	2	1
2	FREQUENCY	790 HZ	979 HZ
3	UNIT/BI	UNI	BI
4	XMIT LEVEL	MEDIUM	MEDIUM
5	PREDICTION SENSOR	PREDICTOR	PREDICTOR
6	WARNING TIME	3000"	35 SEC.
7	APPROACH	3000"	19577"
8	UAX PICKUP DELAY	25 SEC.	25 SEC.
9	UAX RELEASE DELAY	25 SEC.	25 SEC.
10	ISLAND DISTANCE	0	0
11	NUMBER OF DAYS	0	0
12	DAX X TRACK	A,C,F & G TRACK 1	A
		B,D,F & H TRACK 2	B
		0 (PREEMPT)	0 (PREEMPT)
17	DAX X WARNING TIME	35 SEC.	54 SEC.
17	SLAVING	MASTER	MASTER
17	PASSWORD	DISABLED	DISABLED
18	DATA RECORDER	NOT INSTALLED	NOT INSTALLED
19	RS232C BAUD RATE	3000/9600*	1600
20	RS232C DATA BITS	7 (8)*	7 (8)*
21	RS232C STOP BITS	2 (1)*	2 (1)*
21	RS232C PARITY	NONE	NONE
21	DATE	N/A	N/A
47	TIME	N/A	N/A
48	DAYLIGHT SAVINGS TIME	DN	DN
17	SWITCH TO MS EZ LEVEL	DN	DN
17	SWITCH TO MS EZ GCP	0 (OFF)	0 (OFF)
17	PRIME PREDICTION SET	0 (OFF)	0 (OFF)
17	PICKUP DELAY DAX 'X'	15 SEC.	15 SEC.
18	PICKUP DELAY DAX 'Y'	15 SEC.	15 SEC.
19	COMPENSATION VALUE	SET BY SYSTEM	SET BY SYSTEM
		FREQUENCY	FREQUENCY
20	ENHANCED DETECTION	OFF	OFF
21	BACK TO BACK T1 & T2	NG*	ND
20	STATION STOP TIME*	10 SEC.*	10 SEC.
21	NUMBER OF TRACK WIRES	4	4
47	LOW EX ADJUSTMENT*	0*	0*

1 The "X" in parameters identified with a (1) is replaced by A, B, C,D,E,F,G, or H on the display and indicates the DAX affected. The default values associated with the parameters apply to all eight DAX's.

2 Applies only to units equipped with 800444 or 80214 processor module(s)

3 Fill sheet -\$15 according to field set up.

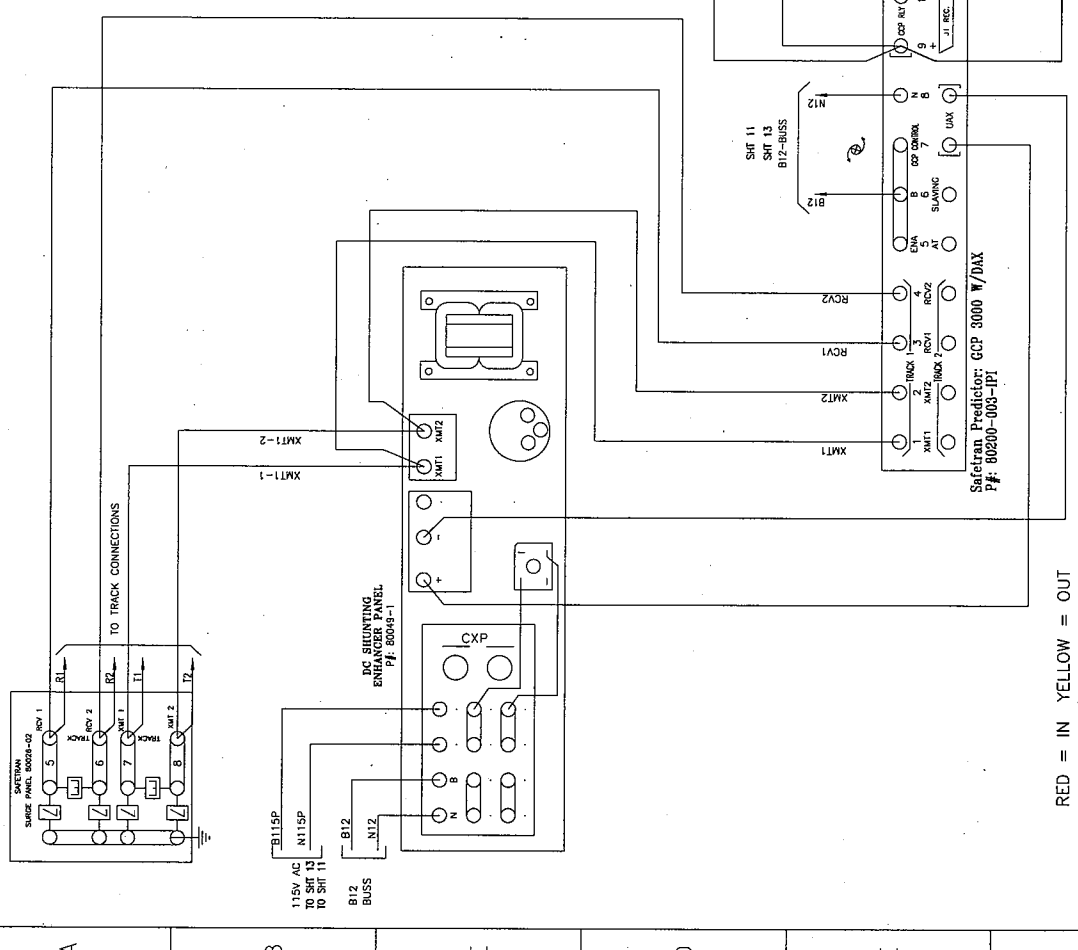

1 ADD MEDIAN GATE "M"

TCS 4/1/08 ACE

NO. BY DATE APPD

REVISION

RED = IN YELLOW = OUT

Safetran Predictor: GCP 3000 W/DAX  
PF: 80200-009-1P1

1. ADD MEDIAN GATE "M"

TCS 4/1/08 ACE

NO. BY DATE APPD

REVISION

RED = IN YELLOW = OUT

Safetran Predictor: GCP 3000 W/DAX  
PF: 80200-009-1P1

1. ADD MEDIAN GATE "M"

TCS 4/1/08 ACE

NO. BY DATE APPD

REVISION

RED = IN YELLOW = OUT

Safetran Predictor: GCP 3000 W/DAX  
PF: 80200-009-1P1


1. ADD MEDIAN GATE "M"

TCS 4/1/08 ACE

NO. BY DATE APPD

REVISION</




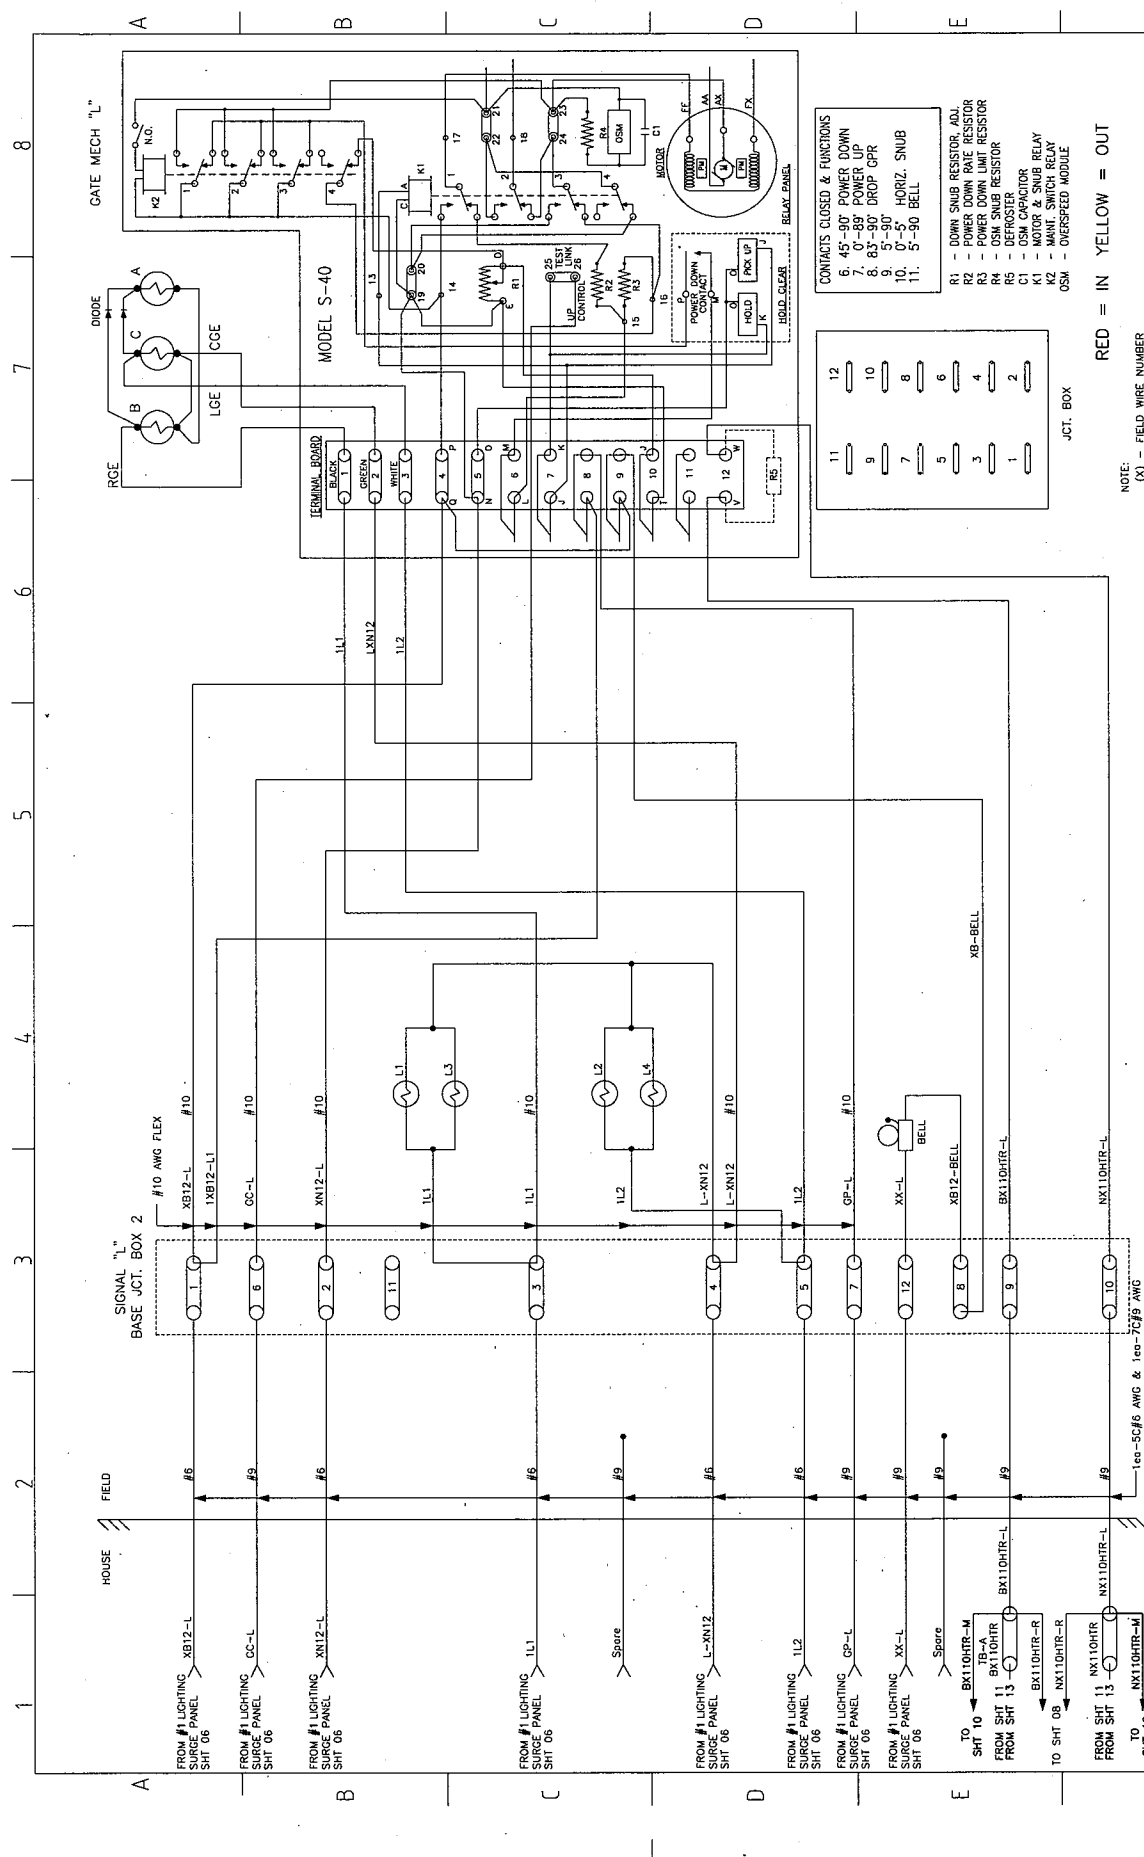

**CONTACTS CLOSED & FUNCTIONS**

- 6. 45°-90° POWER DOWN
- 7. 0°-90° POWER UP
- 8. 63°-90° DROP GPR
- 9. 5°-90°
- 10. 0°-5° HORIZ. SNUB
- 11. 5°-90 BELL

- R1 - DOWN SNUB RESISTOR, ADJ.
- R2 - POWER DOWN RATE RESISTOR
- R3 - POWER DOWN LIMIT RESISTOR
- R4 - OSM SNUB RESISTOR
- R5 - DEFROSTER
- C1 - CAPACITOR
- K1 - MOTOR & SNUB RELAY
- K2 - MANT. SWITCH RELAY
- OSM - OVERSPEED MODULE

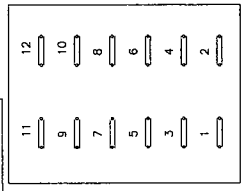

NOTE: (X) - FIELD WIRE NUMBER  
RED = IN YELLOW = OUT

**TRI-CITIES & OLYMPIA RAILROAD**  
 RICHMOND, WA





**SIGNAL GATE "L" CIRCUIT**

DOT NUMBER: 9229751  
 BATELLE BLD.  
 TULSA, OKLAHOMA  
 PHONE: (800) 543-2842 FAX: (918) 234-1529

WWW.RAILROADSIGNALINC.COM


REV. 1  
 23-05-s07  
 07 OF 17 PAGES  
 07 OF 15

NO.	REVISION	BY	DATE	APPD
1	ADD MEDIAN GATE "M"		4/1/08	ACE

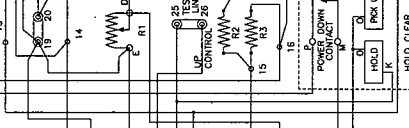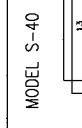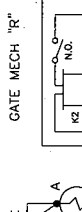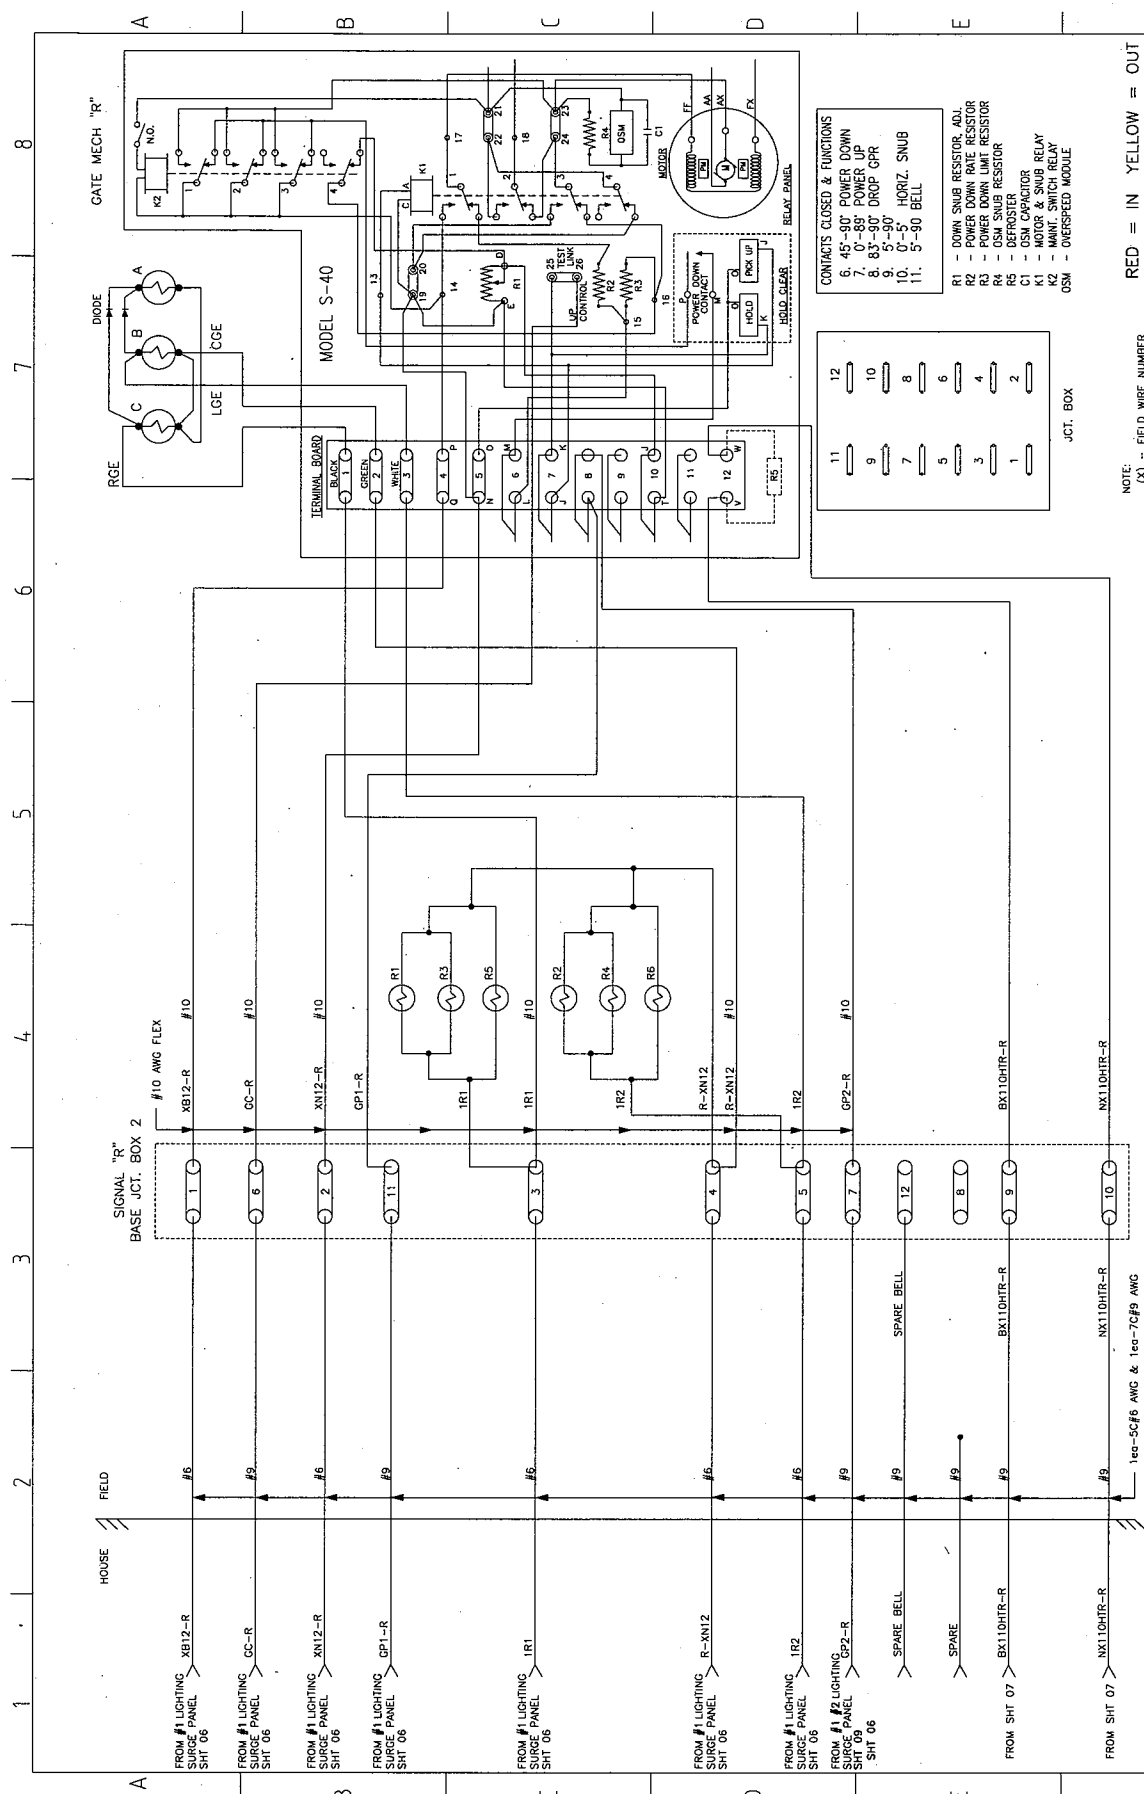

- CONTACTS CLOSED & FUNCTIONS**
- 6. 45°-90° POWER DOWN
  - 7. 0°-85° POWER UP
  - 8. 85°-90° DROP GPR
  - 9. 5°-90° HORIZ. SNUG
  - 10. 0°-5° HORIZ. SNUG
  - 11. 5°-90 BELL

- R1 - DOWN SNUG RESISTOR ADL
- R2 - POWER DOWN RATE RESISTOR
- R3 - POWER DOWN LIMIT RESISTOR
- R4 - OSM SNUG RESISTOR
- R5 - DEFROSTER
- C1 - OSM CAPACITOR
- K1 - MAIN SWITCH RELAY
- K2 - MAIN SWITCH RELAY
- OSM - OVERSPEED MODULE

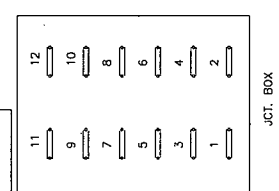

NOTE: (X) - FIELD WIRE NUMBER  
RED = IN YELLOW = OUT

**RAILROAD SIGNAL INTERNATIONAL**  
 PHONE: (800) 543-2842 FAX: (918) 234-1529  
 TULSA, OKLAHOMA  
 WWW.RAILROADSIGNALINC.COM



**TRI-CITIES & OLYMPIA RAILROAD**  
 BATTLE BLVD. RICHMOND, WA  
 SIGNAL GATE "R" CIRCUIT  
 HIGHWAY RAILROAD CROSSING WARNING SYSTEM

REV. 1  
 DATE 4/1/08  
 BY  
 APPD  
 REVISION

NO. 1  
 DATE 2-3-08  
 BY 17100  
 23-05-s08



1 2 3 4 5 6 7 8

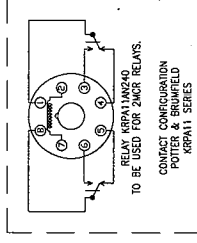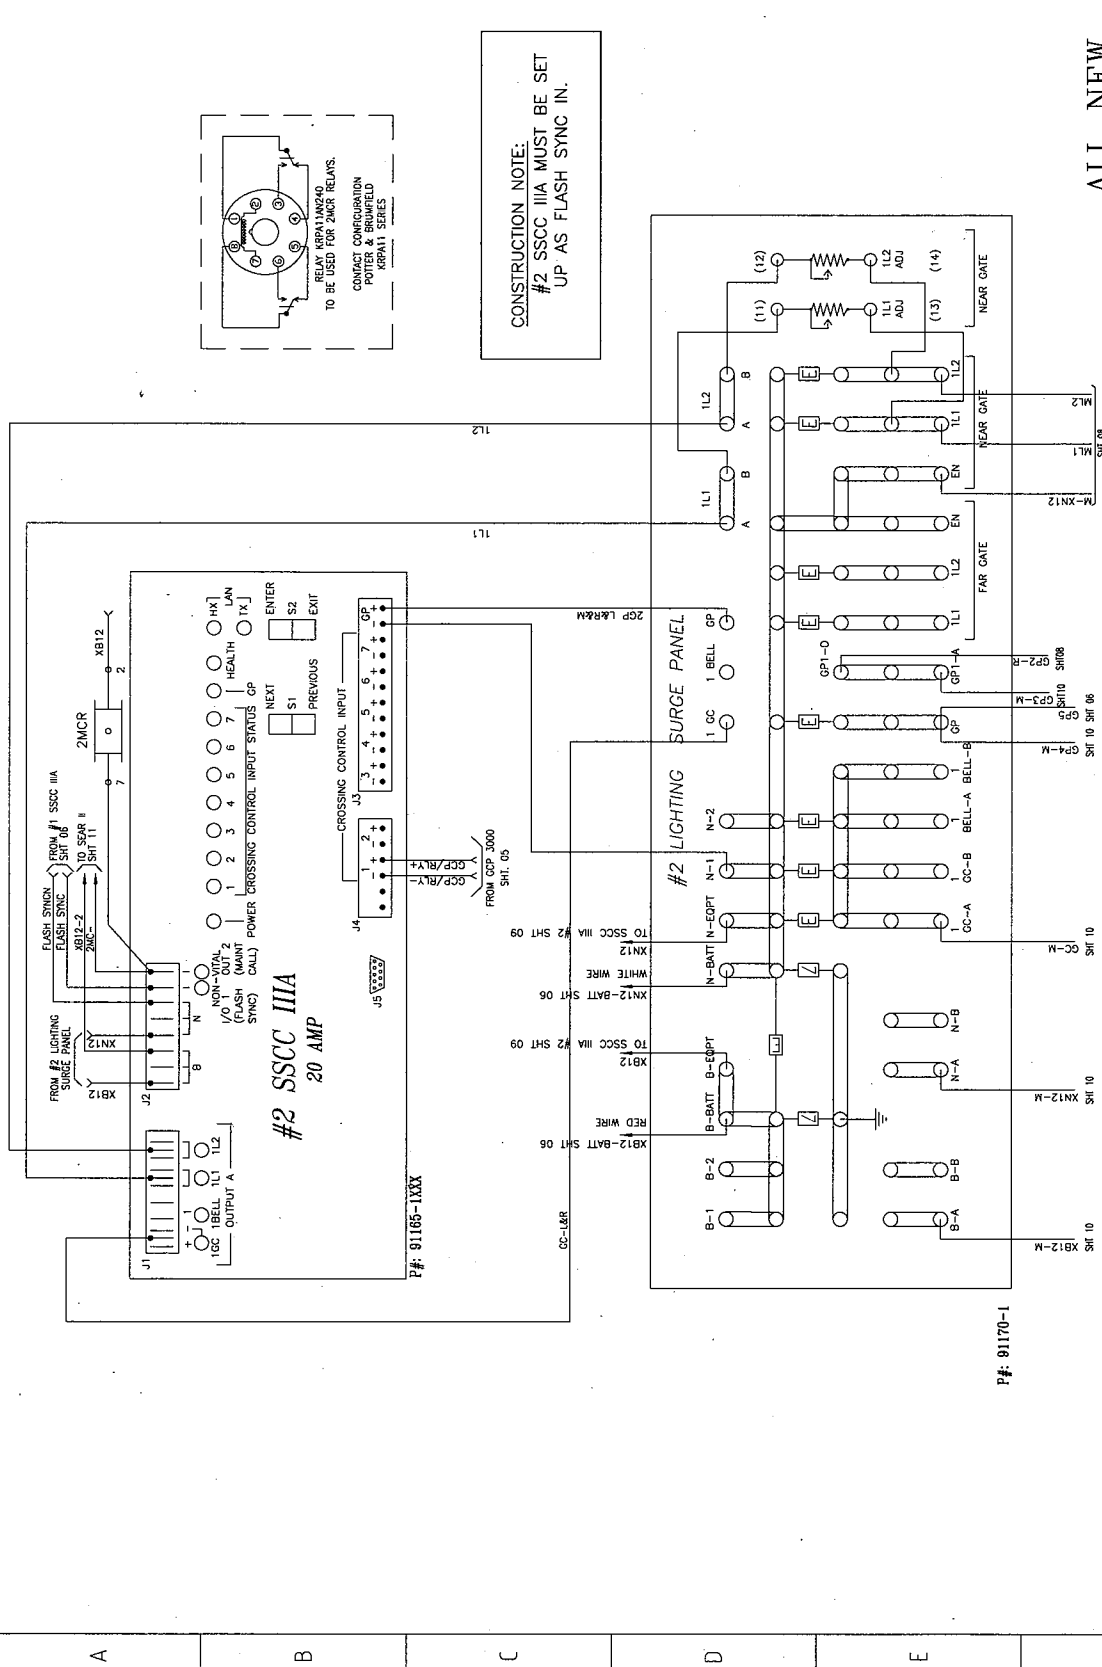


CONSTRUCTION NOTE:  
#2 SSCC IIIA MUST BE SET  
UP AS FLASH SYNC IN.


ALL NEW

RAILROAD SIGNAL INTERNATIONAL, PHONE: (800) 543-2842 FAX: (918) 234-1529 TULSA, OKLAHOMA WWW.RAILROADSIGNALINC.COM		TRI-CITIES & OLYMPIA RAILROAD BATELLE BLVD. RICHLAND, WA	
DOT NUMBER: 9729751		#2 SSCC IIIA CIRCUIT	
PROJECT NO.:		HIGHWAY RAILROAD GRADE CROSSING WARNING SYSTEM	
DRAWN BY: J. MATHIAS		CHECKED BY: J. MATHIAS	
DATE: 09/07/08		SHEET NO.: 23-05-s09	
REVISION:		NO. 1	
BY:		DATE:	
APPD:		DATE:	

8 7 6 5 4 3 2 1

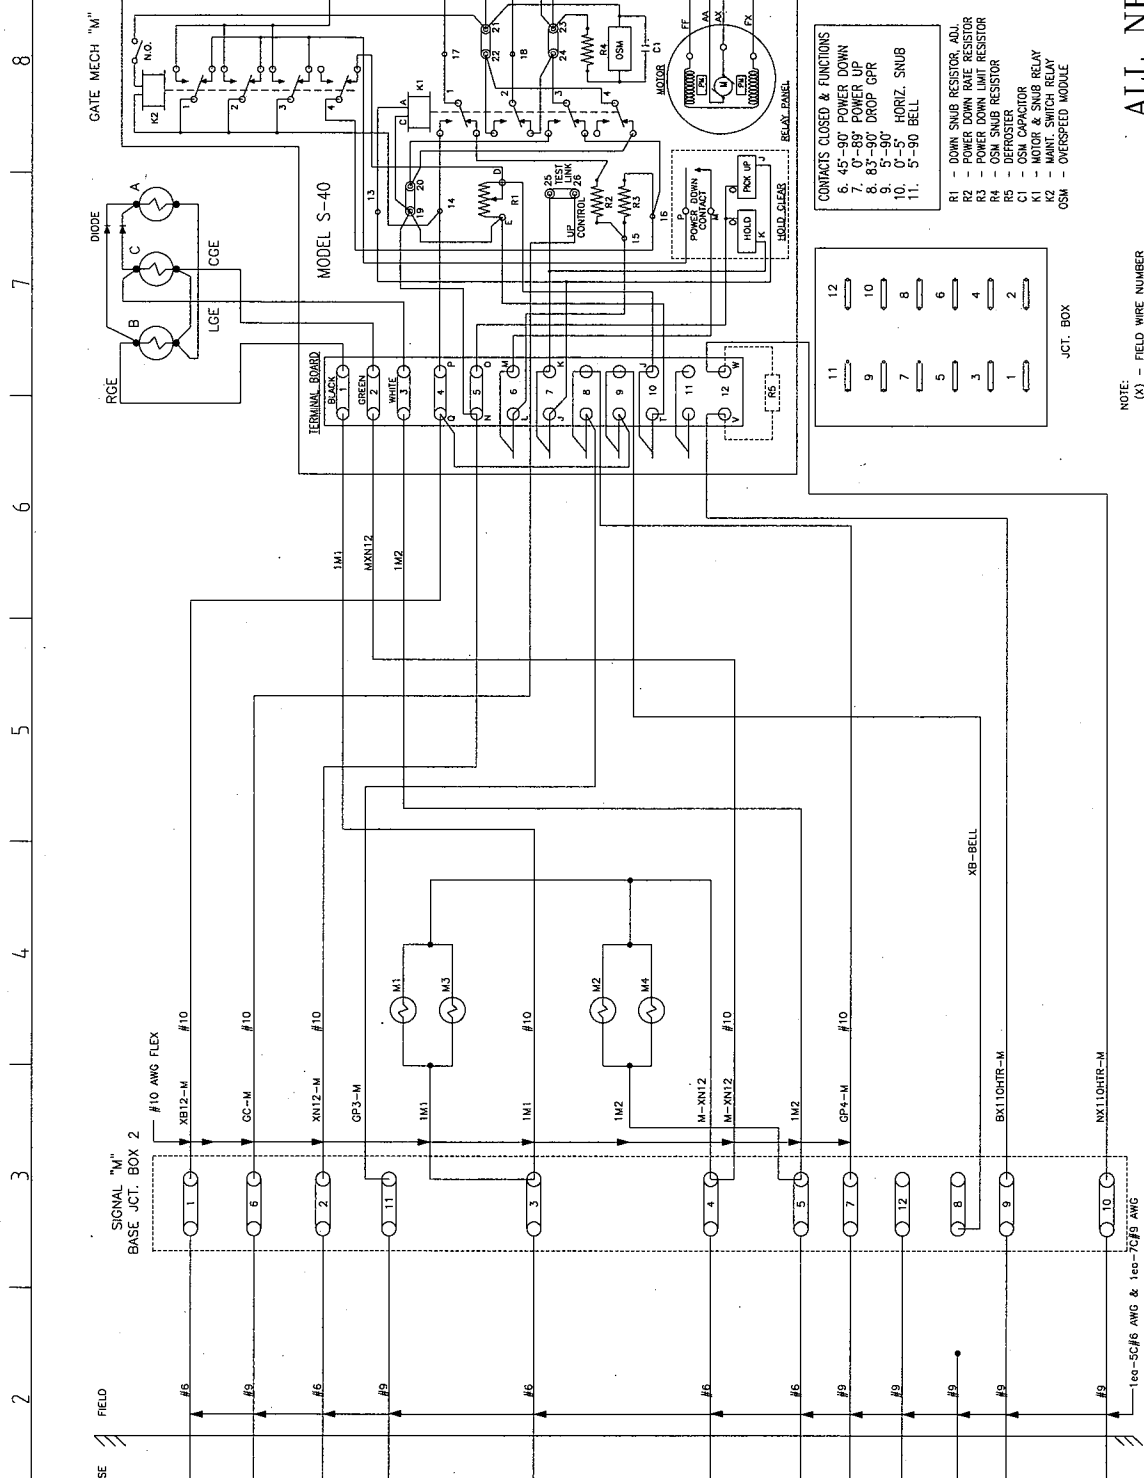

- CONTACTS CLOSED & FUNCTIONS
- 6. 45°-90° POWER DOWN
  - 7. 0°-89° POWER UP
  - 8. 83°-90° DROP GPR
  - 9. 5°-90° HORIZ. SNUB
  - 10. 0°-5° HORIZ. SNUB
  - 11. 5°-90 BELL
- R1 - DOWN SNUB RESISTOR, ADJ.
  - R2 - POWER DOWN RATE RESISTOR
  - R3 - POWER DOWN LIMIT RESISTOR
  - R4 - OSM SNUB RESISTOR
  - R5 - DEBRUISE RESISTOR
  - K1 - MOTOR & SNUB RELAY
  - K2 - MAINT. SWITCH RELAY
  - OSM - OVERSPEED MODULE

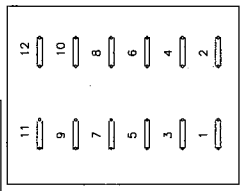

NOTE: (X) - FIELD WIRE NUMBER

**ALL NEW**

**TRI-CITIES & OLYMPIA RAILROAD**

**SIGNAL GATE "M" CIRCUIT**

LOT NUMBER: 9229751  
 PROJECT NO: 9229751  
 DRAWN BY & DATE: J.M. 04/01/08  
 CHECKED BY: J.M. 04/01/08  
 SHEET NO: 10 OF 17  
 INCHES: 23-05-s10  
 REV: 0

**RAILROAD SIGNAL INTERNATIONAL**

PHONE: (800) 543-2842 FAX: (918) 234-1529

TULSA, OKLAHOMA


WWW.RAILROADSIGNALINC.COM

1 | ADD MEDIAN GATE "M"

TCS 4/1/08 ACE

NO. | REVISION | BY | DATE | APPD

1 2 3 4 5 6 7 8

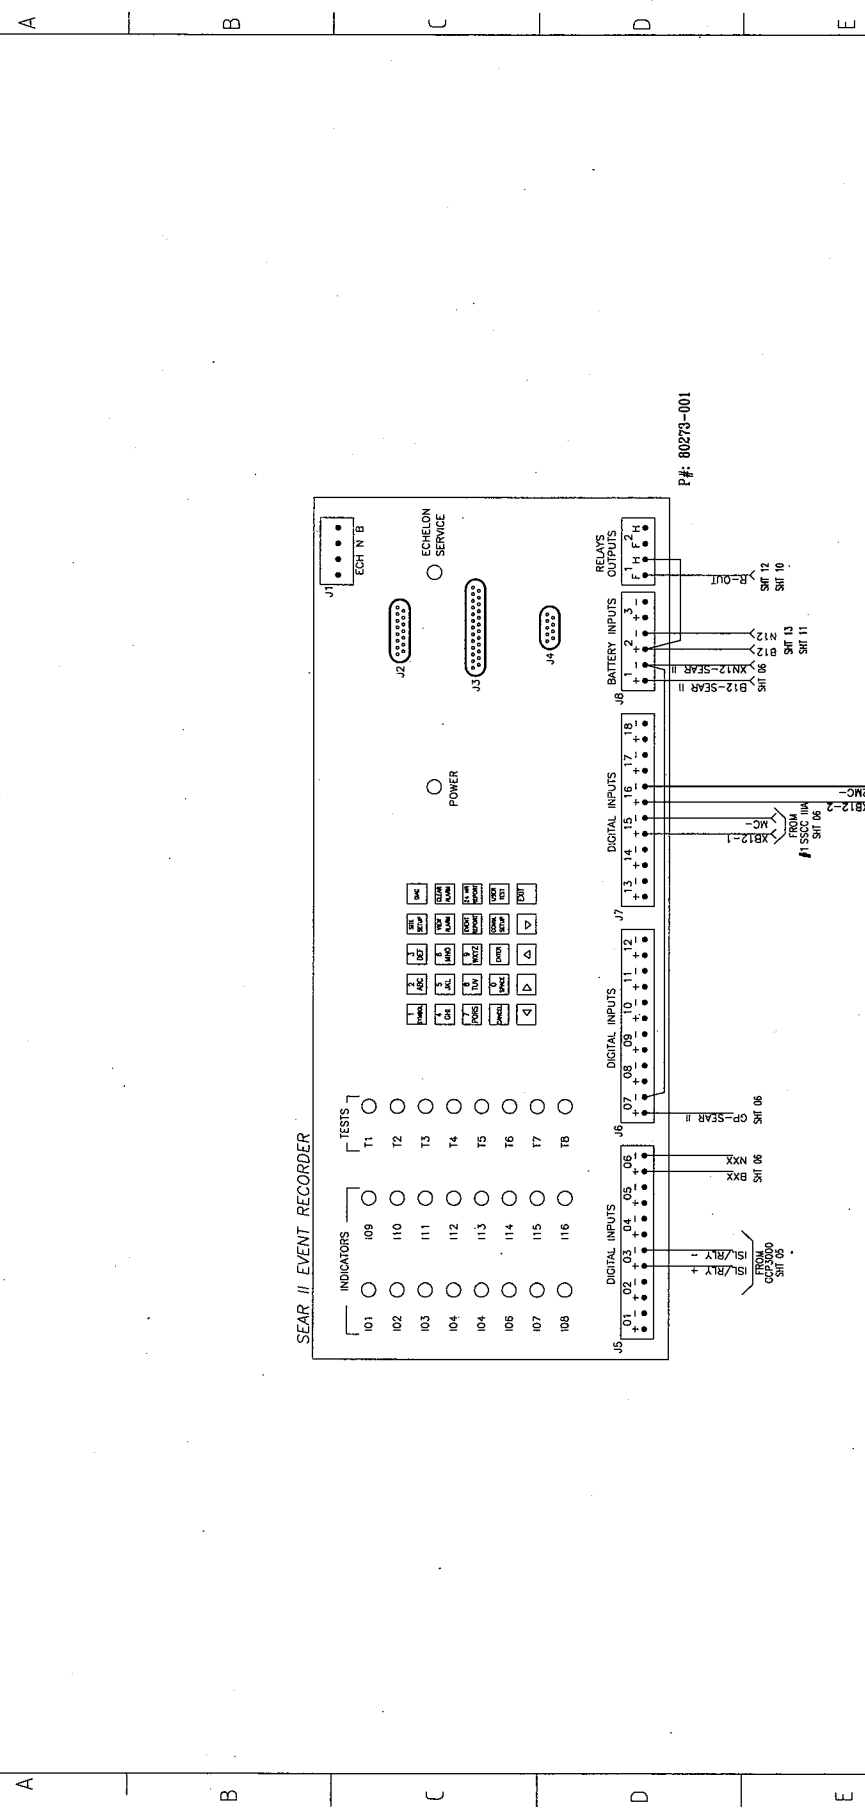

SEAR II EVENT RECORDER

PN: 80273-001


RED = IN YELLOW = OUT

1 ADD MEDIAN GATE "M"		TGS	4/1/08	AGE
NO.	REVISION	BY	DATE	APPD

RAILROAD SIGNAL INTERNATIONAL		TRI-CITIES & OLYMPIA RAILROAD	
PHONE: (800) 543-7842 FAX: (918) 234-1529		BATTELLE BLVD. RICHMOND, WA	
TULSA, OKLAHOMA		SEAR II EVENT RECORDER	
WWW.RAILROADSIGNALINC.COM		HIGHWAY RAILROAD GRADE CROSSING WARNING SYSTEM	
		PROJECT NO: 23-05-RICH	
		REVISED BY: JAC	
		DATE: 06/29/2005	
		DRAWN BY: JAC	
		CHECKED BY: JAC	
		DATE: 06/29/2005	
		PROJECT NO: 23-05-s11 09	
		REV: 1	


1 2 3 4 5 6 7 8

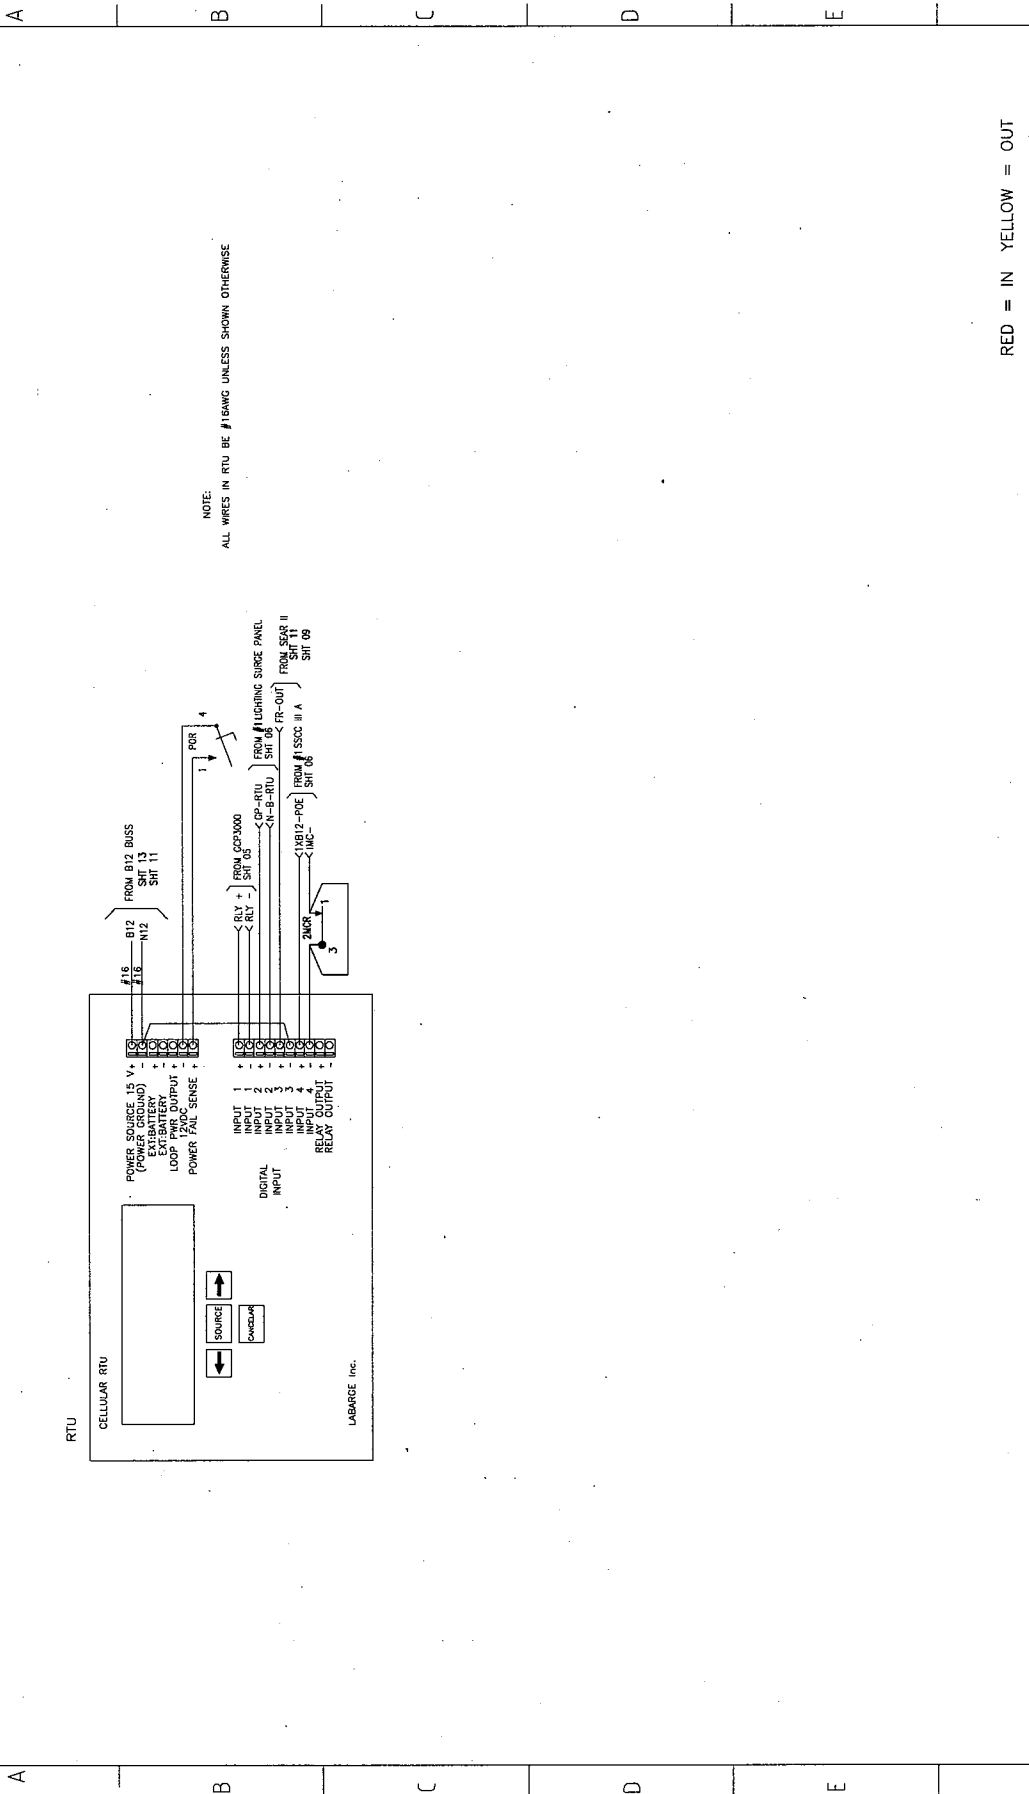

NO.	1	2	3	4	5	6	7	8
REVISION								
BY								
DATE								
APPD								
TCS	4/1/08	ACE						
<p>1 ADD MEDIAN GATE "M"</p>								
<p><b>RAILROAD SIGNAL INTERNATIONAL</b>          PHONE: (800) 543-2842 FAX: (918) 234-1529          TULSA, OKLAHOMA          WWW.RAILROADSIGNALINC.COM</p>								
<p><b>TRI-CITIES &amp; OLYMPIA RAILROAD</b>          BATTLE BLVD. RICHLAND, WA          RTU CIRCUIT          HIGHWAY RAILROAD GRADE CROSSING WARNING SYSTEM          DRAWN BY: DATE: SHEET NO. 23-05-s12 10 OF 17          PROJECT APPROVED BY: M. Castro A.R. 05/26/2005 10 OF 15</p>								
<p>DOT NUMBER: 922975L          PROJECT APPROVED BY: E. Burris          RICHLAND, WA</p>								

RED = IN YELLOW = OUT

1 2 3 4 5 6 7 8

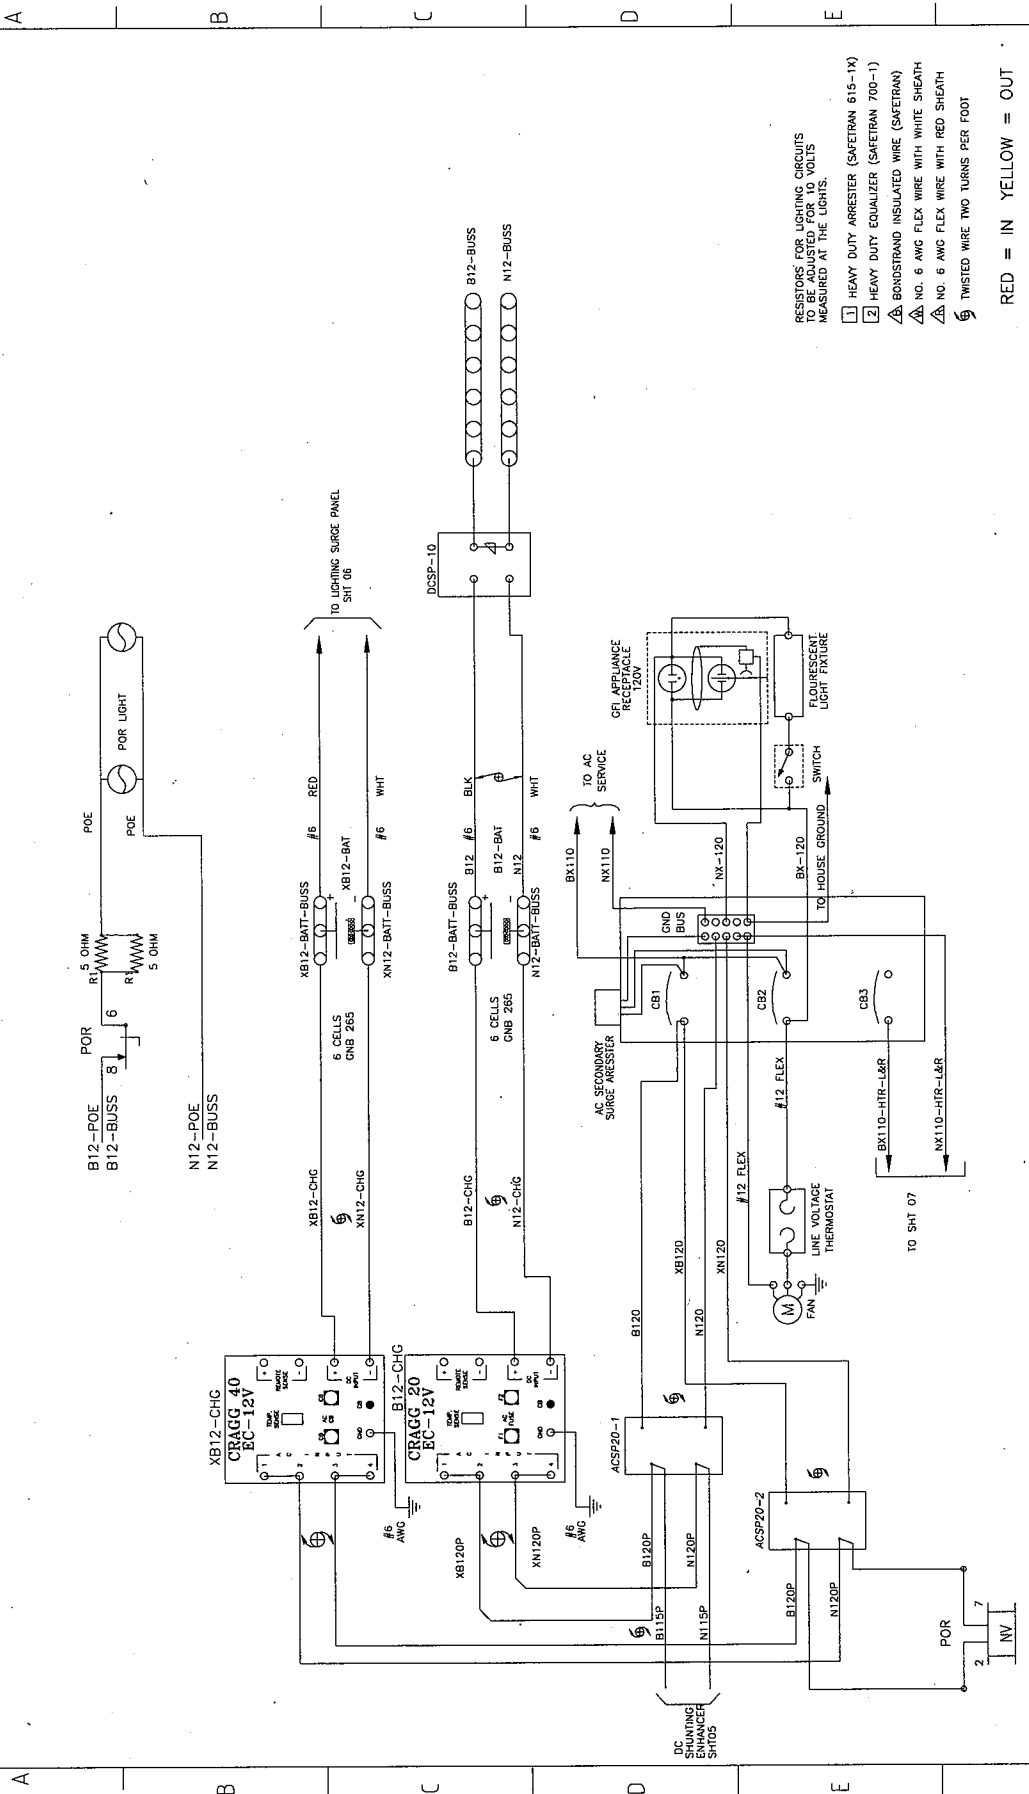


- RESISTORS FOR LIGHTING CIRCUITS TO BE ADJUSTED FOR 10 VOLTS MEASURED AT THE LIGHTS.
- 1 HEAVY DUTY ARRESTER (SAFETRAN 615-1X)
  - 2 HEAVY DUTY EQUALIZER (SAFETRAN 700-1)
  - 3 BONDSTRAND INSULATED WIRE (SAFETRAN)
  - 4 NO. 6 AWG FLEX WIRE WITH WHITE SHEATH
  - 5 NO. 6 AWG FLEX WIRE WITH RED SHEATH
  - 6 TWISTED WIRE TWO TURNS PER FOOT

RED = IN YELLOW = OUT

NO. 1		ADD MEDIAN GATE "M"		NO.		REVISION		BY DATE APPD		NO.	
ICS		4/1/08		ACE							
<p style="text-align: center;"><b>RAILROAD SIGNAL INTERNATIONAL</b>          PHONE: (800) 543-2842 FAX: (918) 234-1529          TULSA, OKLAHOMA          WWW.RAILROADSIGNALINC.COM</p>											
<p style="text-align: center;"><b>TRI-CITIES &amp; OLYMPIA RAILROAD</b></p>				<p style="text-align: center;">BATELLE BLD.          RICHMOND, WA</p>				<p style="text-align: center;">POWER DISTRIBUTION          HIGHWAY RAILROAD GRADE CROSSING WARNING SYSTEM</p>			
PROJECT NUMBER 922975L		DRAWN BY & DATE E. Burns 06/05/2005		CHECKED BY M. Castro 11/07/05		SHEET NO. 13 OF 17		NO. OF SHEETS 17		REV. NO. 8	



1 2 3 4 5 6 7 8

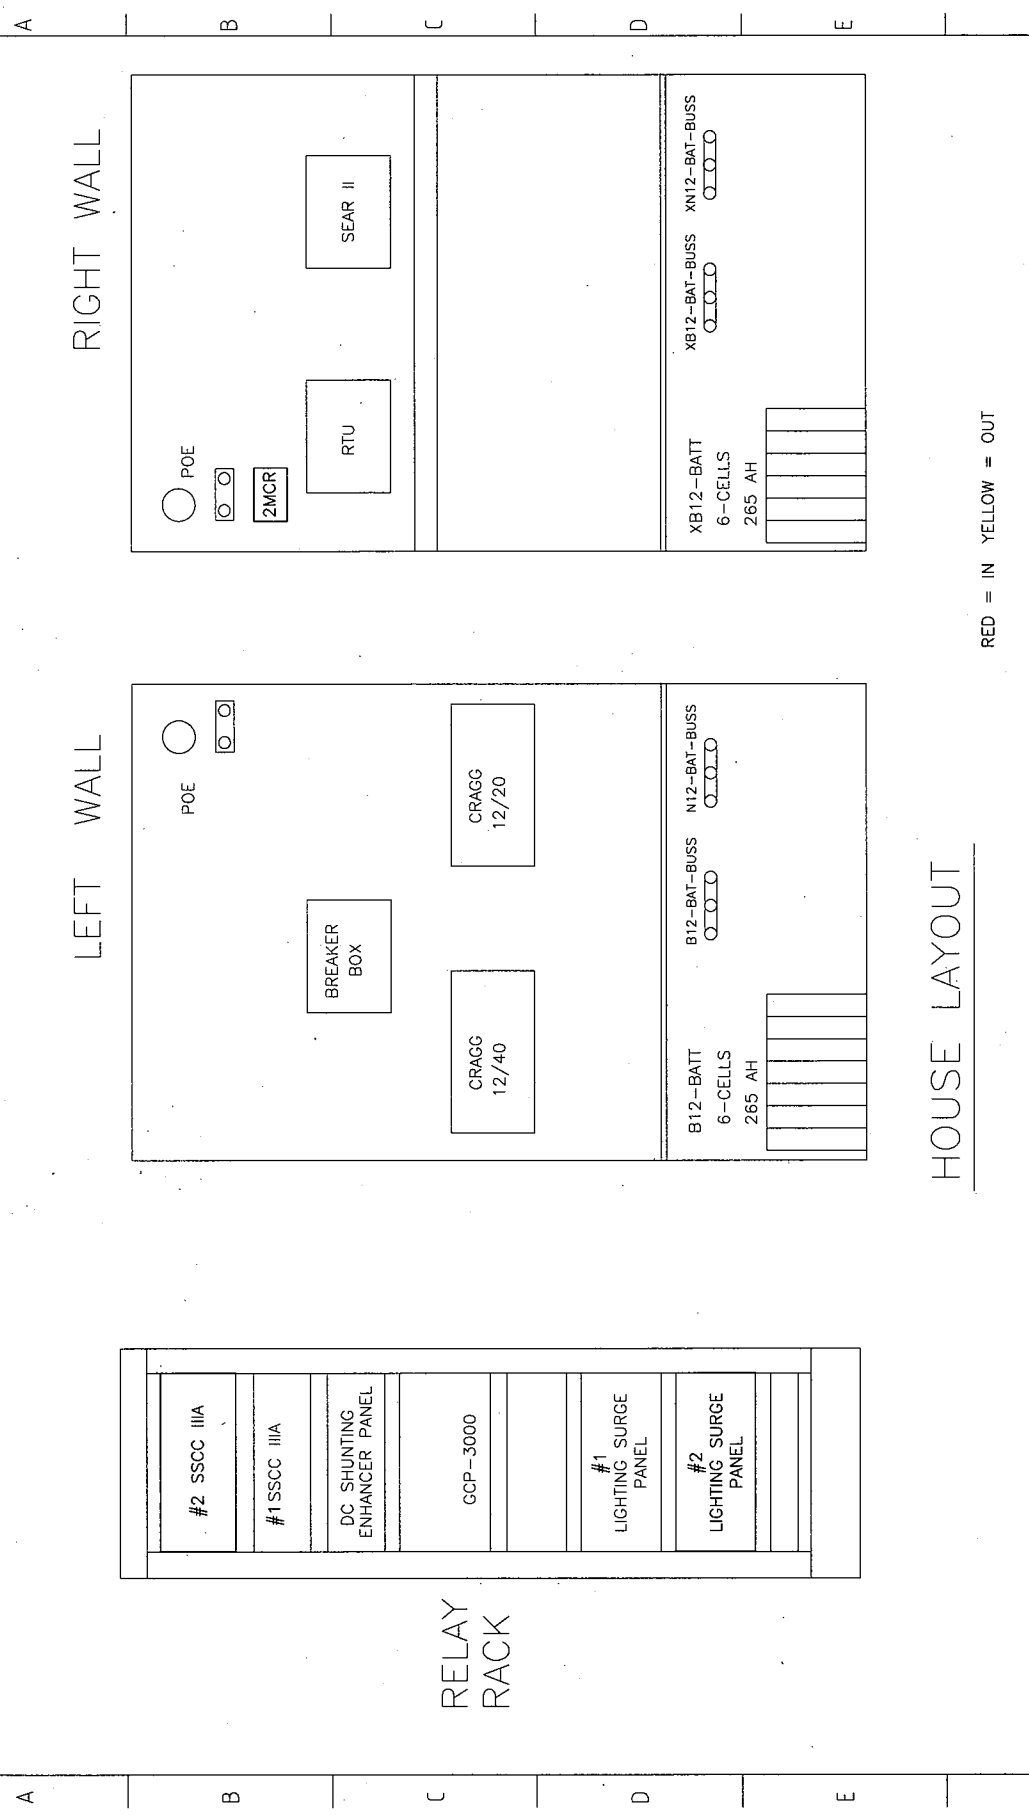



HOUSE LAYOUT

NO.	REVISION	BY	DATE	APPD
1				
TCS		4/1/08	ACE	
<p><b>RA</b></p> <p><b>RAILROAD SIGNAL INTERNATIONAL,</b>          PHONE: (800) 543-2842 FAX:(918) 234-1529          TULSA, OKLAHOMA          WWW.RAILROADSIGNALINC.COM</p>				
<p><b>TRI-CITIES &amp; OLYMPIA RAILROAD</b>          BATELLE BLVD. RICHMOND, WA</p>		<p>HOUSE LAYOUT          HIGHWAY RAILROAD GRADE CROSSING WARNING SYSTEM          PROJECT NO. 23-05-RICH          DATE: 06/26/2006 14 OF 17 PAGES          E. Burns M.C. 23-05-s14 12 8</p>		


1 2 3 4 5 6 7 8

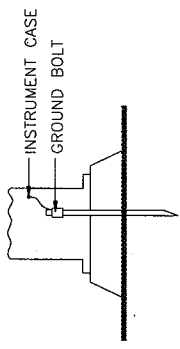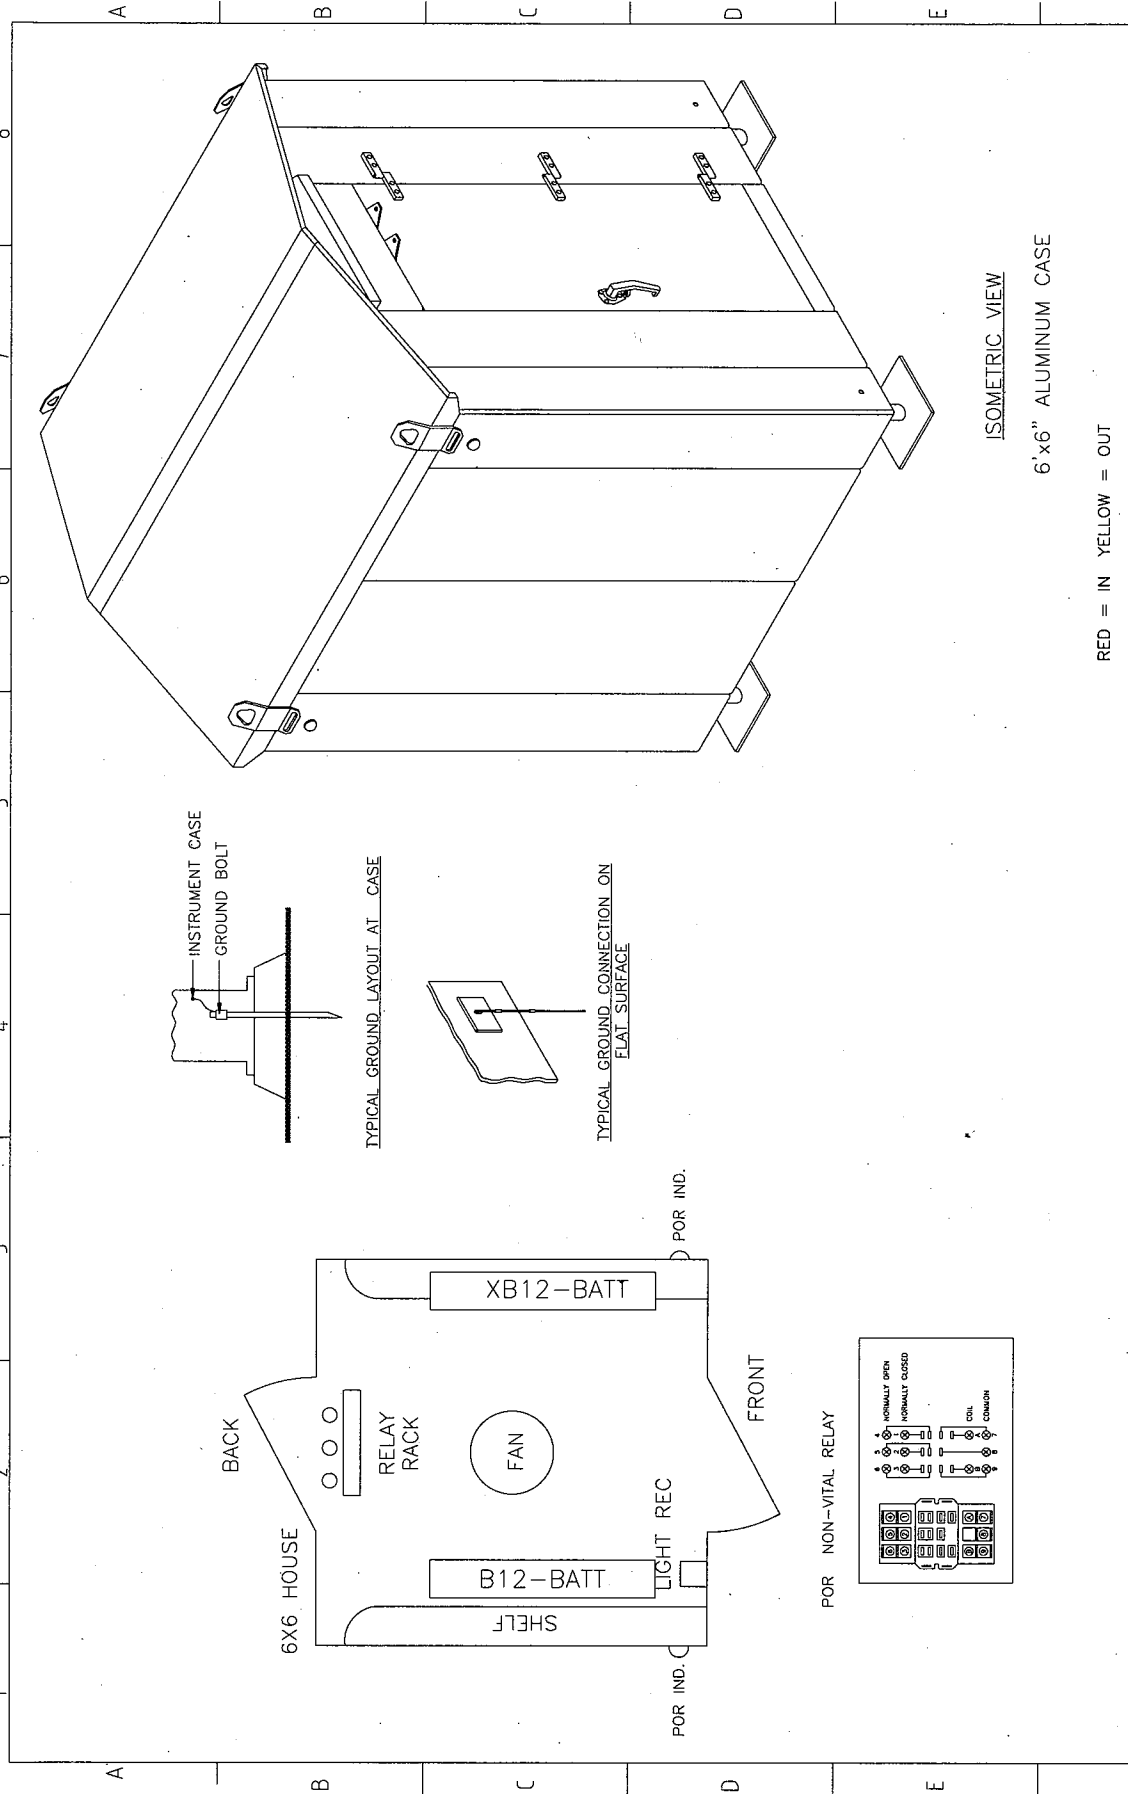

TYPICAL GROUND LAYOUT AT CASE

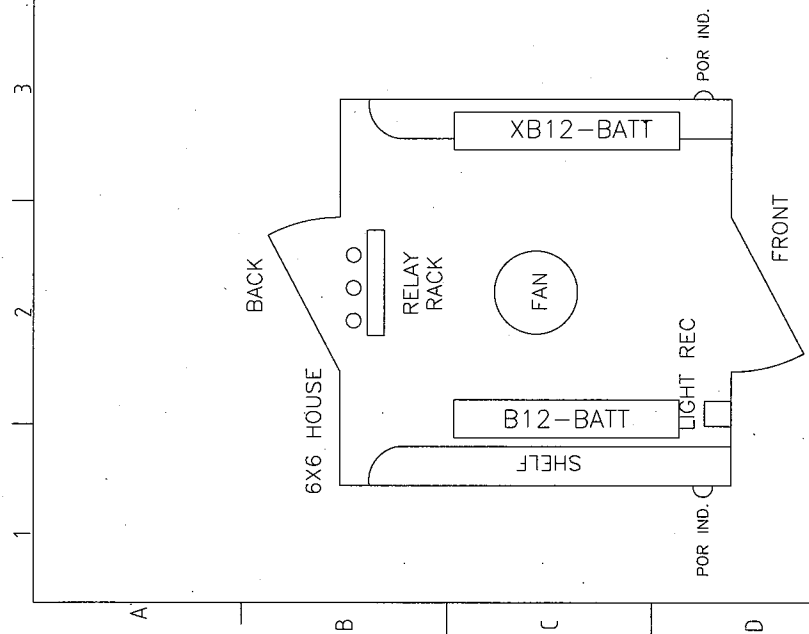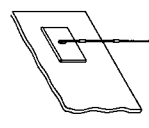

FOR NON-VITAL RELAY

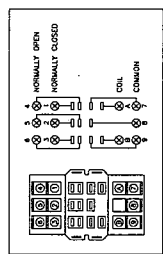

RED = IN YELLOW = OUT

NO.	REVISION	BY	DATE	APPD
1	ADD MEDIAN GATE "M"		4/1/08	ACE


  

DOT NUMBER	922975L
PROJECT	23-05-RICH
SEARCH AREA	McClure
DATE	05/26/06
BY	AS
CHKD	15
DATE	06/17/06
BY	13
CHKD	10
DATE	07/15
BY	7
CHKD	13
DATE	08/15
BY	8
CHKD	1
DATE	23-05-s15.13
REV.	1

RAILROAD SIGNAL INTERNATIONAL	TRI-CITIES & OLYMPIA RAILROAD
PHONE: (800) 543-2842 FAX: (918) 234-1529	BATTELLE BLD. RICHMOND, WA
TULSA, OKLAHOMA	HOUSE LAYOUT DETAILS
WWW.RAILROADSIGNALINC.COM	HIGHWAY RAILROAD GORGE CROSSING WARNING SYSTEM

1 2 3 4 5 6 7 8

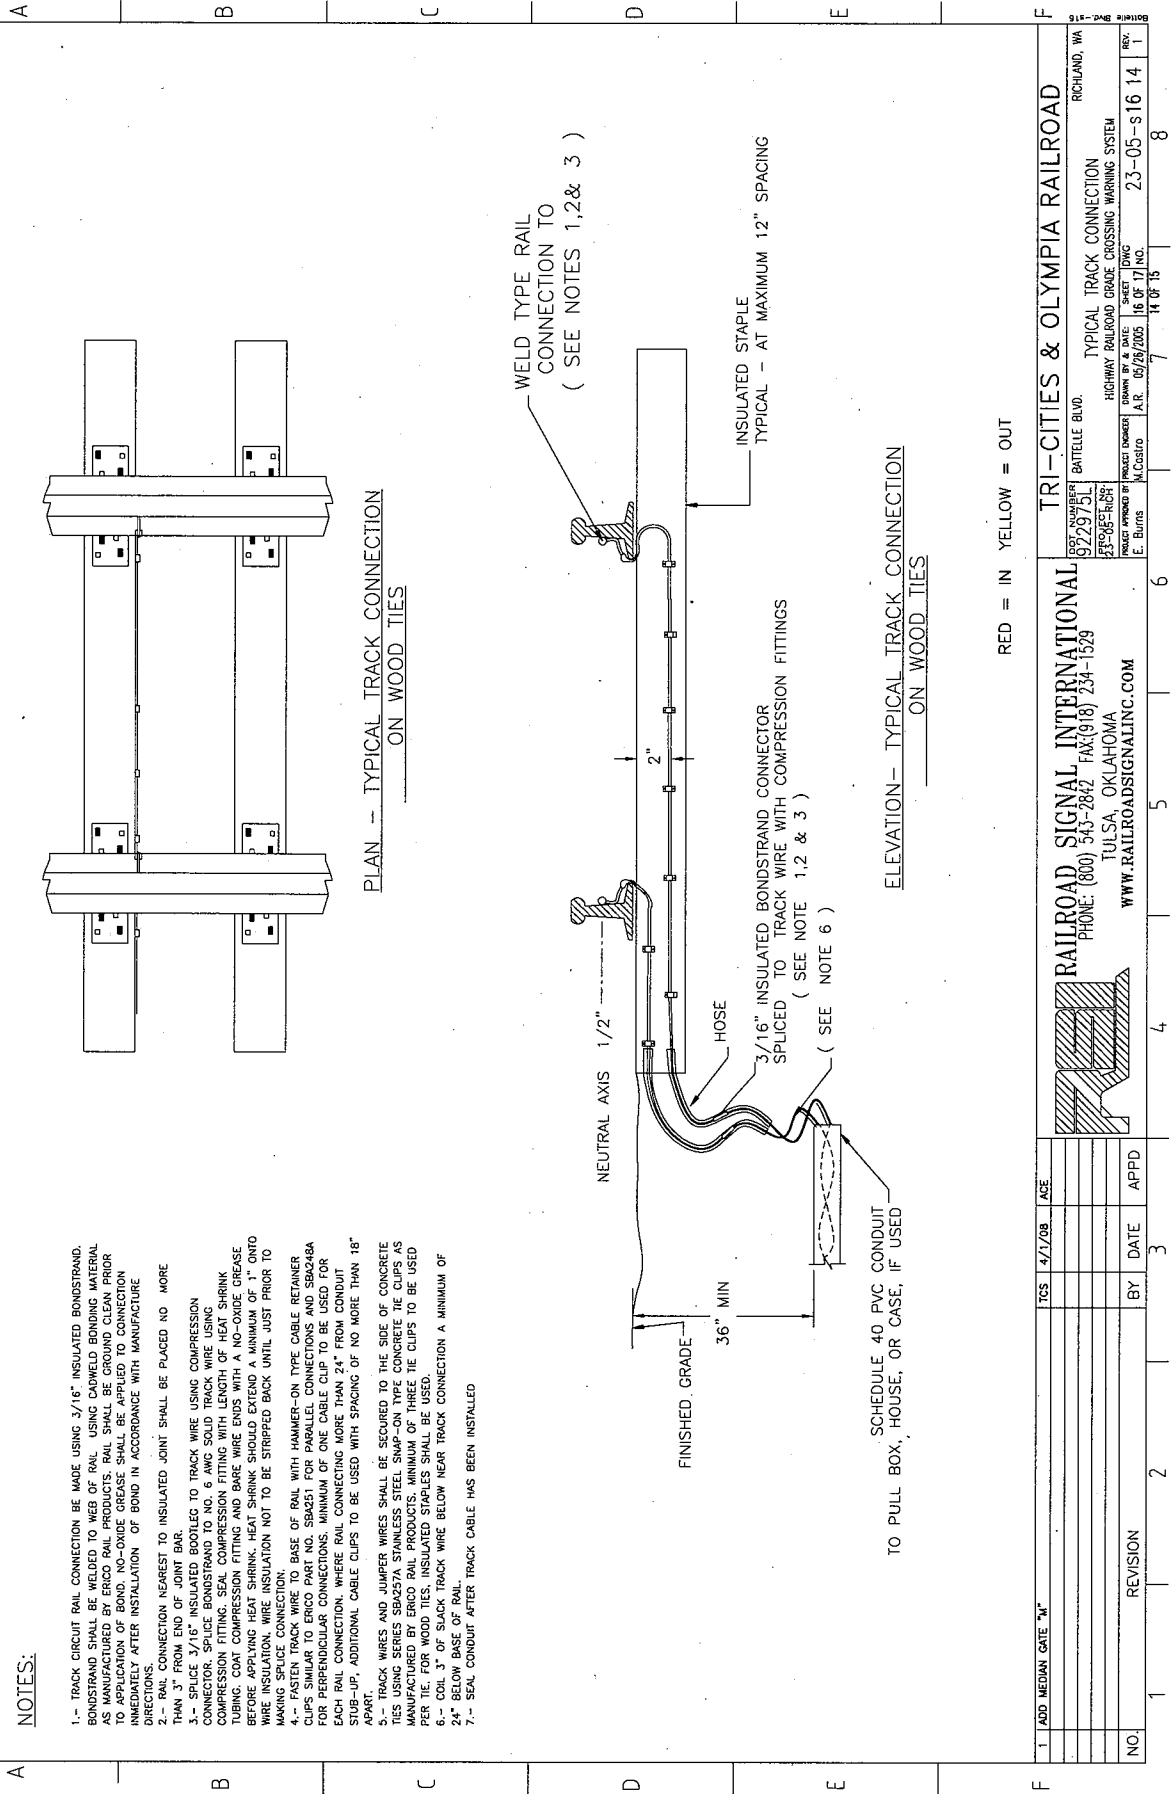

**NOTES:**

- 1.- TRACK CIRCUIT RAIL CONNECTION BE MADE USING 3/16" INSULATED BONDSTRAND. BONDSTRAND SHALL BE WELDED TO WEB OF RAIL USING CADWELD BONDING MATERIAL AS MANUFACTURED BY ERICO RAIL PRODUCTS. RAIL SHALL BE GROUND CLEAN PRIOR TO APPLICATION OF BOND. NO-OXIDE GREASE SHALL BE APPLIED TO CONNECTION IMMEDIATELY AFTER INSTALLATION OF BOND IN ACCORDANCE WITH MANUFACTURE DIRECTIONS.
- 2.- CONNECTION NEAREST TO INSULATED JOINT SHALL BE PLACED NO MORE THAN 3" FROM END OF JOINT BAR.
- 3.- SPlice 3/16" INSULATED BOOTLEG TO TRACK WIRE USING COMPRESSION CONNECTOR. SPlice BONDSTRAND TO NO. 6 AWG SOLID TRACK WIRE USING COMPRESSION FITTING. SEAL COMPRESSION FITTING WITH LENGTH OF HEAT SHRINK TUBING. COAT COMPRESSION FITTING AND BARE WIRE ENDS WITH A NO-OXIDE GREASE BEFORE APPLYING HEAT SHRINK. HEAT SHRINK SHOULD EXTEND A MINIMUM OF 1" ONTO WIRE INSULATION. WIRE INSULATION NOT TO BE STRIPPED BACK UNTIL JUST PRIOR TO MAKING SPlice CONNECTION.
- 4.- FASTEN TRACK WIRE TO BASE OF RAIL WITH HAMMER-ON TYPE CABLE RETAINER CLIPS SIMILAR TO ERICO PART NO. SB8251 FOR PARALLEL CONNECTIONS AND SB2028A FOR PERPENDICULAR CONNECTIONS. CABLE CLIPS TO BE USED FOR EACH RAIL CONNECTION. WIRE TO BE CONNECTED TO WIRE WORK 24" FROM JOINT. STUB-UP, ADDITIONAL CABLE CLIPS TO BE USED WITH SPACING OF NO MORE THAN 18" APART.
- 5.- TRACK WIRES AND JUMPER WIRES SHALL BE SECURED TO THE SIDE OF CONCRETE TIES USING SERIES SB257A STAINLESS STEEL SNAP-ON TYPE CONCRETE TIE CLIPS AS MANUFACTURED BY ERICO RAIL PRODUCTS. MINIMUM OF THREE TIE CLIPS TO BE USED PER TIE. FOR WOOD TIES, INSULATED STAPLES SHALL BE USED.
- 6.- COIL 3" OF SLACK TRACK WIRE BELOW NEAR TRACK CONNECTION A MINIMUM OF 24" BELOW BASE OF RAIL.
- 7.- SEAL CONDUIT AFTER TRACK CABLE HAS BEEN INSTALLED.

PLAN -- TYPICAL TRACK CONNECTION  
ON WOOD TIES

ELEVATION-- TYPICAL TRACK CONNECTION  
ON WOOD TIES

RED = IN YELLOW = OUT

NO.	REVISION	BY	DATE	APPD
		ACE	4/1/08	
TCS				
ADD MEDIAN GATE "M"				
<p><b>RAILROAD SIGNAL INTERNATIONAL</b>          PHONE: (800) 543-2842 FAX: (918) 234-1529          TULSA, OKLAHOMA          WWW.RAILROADSIGNALINC.COM</p>				
<p><b>TRI-CITIES &amp; OLYMPIA RAILROAD</b>          RICHMOND, WA          TYPICAL TRACK CONNECTION          HIGHWAY RAILROAD GORGE CROSSING WARNING SYSTEM          PROJECT NUMBER: 23-05-RCR          DRAWN BY: M. COLE          CHECKED BY: M. COLE          DATE: 05/26/05          SCALE: AS SHOWN          REV. 1: 23-05-S16 14          REV. 2: 08/17/05          REV. 3: 11/07/05</p>				





## SECTION 13200

### GRADE CROSSING GATE SYSTEM CONSTRUCTION

#### PART 1 – GENERAL

##### 1.1. SUMMARY

- 1.1.1. The work of this section shall consist of the procurement and installation of the additional median entrance gate at Battelle Boulevard, Richland, WA. The Work includes, but is not limited to: procure all material, assemble and install gate control equipment, new crossing gate, lights, underground conduit and wire, aligning signal lights, and replacement of existing gate arm on opposite side of road.
- 1.1.2. It shall be the Contractor's responsibility to follow the design as provided by the City of Richland, WA, provide and install all materials and equipment, including final inspection and placement of the gate in service. All CAD revisions of circuit plans shall be the responsibility of the City of Richland, WA.

##### 1.2. REFERENCES

- 1.2.1. AMERICAN RAILWAY ENGINEERING AND MAINTENANCE OF WAY ASSOCIATION (AREMA)
  - 1.2.1.1.1. Manual for Railway Engineering (AREMA Manual)
  - 1.2.1.1.2. Portfolio of Trackwork Plans (AREMA Portfolio)
- 1.2.2. AMERICAN SOCIETY FOR TESTING AND MATERIALS (ASTM)
- 1.2.3. AMERICAN ASSOCIATION OF RAILROADS (AAR)
- 1.2.4. AMERICAN NATIONAL STANDARDS INSTITUTE (ANSI)
  - 1.2.4.1.1. National Electrical Code
- 1.2.5. FEDERAL HIGHWAY ADMINISTRATION
  - 1.2.5.1.1. Manual on Uniform Traffic Control Devices
- 1.2.6. FEDERAL RAILWAY ADMINISTRATION (FRA)
  - 1.2.6.1.1. Rules and Regulations Governing Railroad Signal and Train Control Systems
  - 1.2.6.1.2. Track Safety Standards

1.2.7. WASHINGTON STATE DEPARTMENT OF TRANSPORTATION  
(WSDOT)

1.2.7.1.1. Washington State Utilities and Transportation Commission –  
Washington Administrative Code

1.2.7.1.2. Standard Specifications

1.2.8. RELATED WORK

None

1.3. SUBMITTALS

1.3.1. None

2. PART 2 – PRODUCTS

2.1. GENERAL

2.1.1. All material shall be new and shall be guaranteed against defects in material and workmanship, damage caused by normal wear and tear excluded, for a period of one (1) year from date of final acceptance.

2.2. SIGNAL MATERIAL

The Contractor shall install the following materials:

2.2.1. Conduit – Contractor shall install 4-in steel rigid conduit, elbows, sleeves, and threaded couplers for cabling under roadways and track.

2.2.2. Cable – Contractor shall install Okonite 5C#6 (Part No. 206-11-6245), 7C#9 (Part No. 206-11-6927) or approved equal solid coated copper cable which meets AAR insulation requirements for underground wire.

2.2.3. Mast Wire – Mast wire to gate mounted flashers and cantilever mounted flashers to be 5C#10 stranded type TC, Okonite PN 202-10-3505, DWG DL 05

2.2.4. Case wire - Case wire to be Okonite nylon braid case wire, except #6 AWG wire for battery circuits.

2.2.5. Battery circuit wire - Battery circuit wires to be 6 AWG copper stranded. Red w/nylon jacket for positive battery, black w/nylon jacket for negative battery and green w/nylon jacket for ground.

2.2.6. Eyelets – Contractor shall supply ¼-in ring eyelets for #6, #9, #10 and #16 wire.

2.2.7. Signal Gates – Gates to be Safetran Model S-40 and shall consist of:

2.2.7.1. Gate mechanism (or approved equal), with mounting hardware, counter weights, and gate arm supports.

2.2.7.2. Aluminum mast of approximately 16-ft high x 5-in diameter with aluminum split base junction box assembly.

2.2.7.3. 12" FLX-2000 (or approved equal) 2-way flashing light assembly with L.E.D. Lights, and aluminum hoods and backgrounds.

2.2.7.4. Electronic bell – none required.

2.2.7.5. High wind support bracket shall be manufactured to industry standards.

2.2.7.6. The cross bucks sign shall be constructed of aluminum with high intensity reflective sheeting and mounted with 9" standoff brackets.

2.2.7.7. A lock shall be provided for the gate mechanism that conforms with the Tri Cities and Olympia Railroad types of lock and key.

2.2.8. Gate arms - Gate arms shall be EZ-Gate (or approved equal) with High Wind Profile extendable roadway arm with lens encapsulated high intensity red and white sheeting and 4-ft sleeve. Gate arms to be equipped with LED gate lights. Gate shall be attached to gate mechanism with conversion bracket with National Electric Gate Co, fabricated adapter. (or approved equal) (Part No. 385102-175-2SL).

2.2.9. Gate foundation to be concrete.

2.2.10. Sealing Compound – Contractor shall provide sealing grout and/or duct seal. Foam Sealant is not to be used.

### 2.3. SIGNAL HOUSE

2.3.1. Wire ties are to be kept to a minimum. Internal wiring shall run in plastic wireways or wireways integral to the house, such as, upper raceways for overhead wires.

2.3.2. All wiring and electronic components shall be labeled with printed tags to conform with 49 CFR 234.

2.3.3. Details for house and component layout are to conform to signal plans. Erico 4-post terminals with test links shall be used on all gate and light circuits leaving the bungalow.

2.3.4. Instrument house wire shall conform to section 2.2: Signal Material.

- 2.3.5. All wires shall be terminated using molded terminal blocks per AAR Signal Manual Part 14.1.5.
- 2.3.6. All stranded wiring connections are to be made with AMP insulated compression eyelets. The attached terminal shall have no bare wire showing, nor shall the insulation on the terminal be cracked or broken. The terminal shall be tightly attached to the wire so that it can not be pulled off without damaging the terminal.
- 2.3.7. Each end of a wiring circuit is to be identified by a sleeve tag on the wire bearing the name of the circuit and the location it is connecting to.

## 2.4. POWER SERVICE

Not Applicable

## PART 3 - EXECUTION

### 3.1. GENERAL

- 3.1.1. Signal construction shall conform to the requirements of the American Association of Railroads, except as modified herein.
- 3.1.2. The Contractor shall give the Engineer a minimum of ten (10) working days notice prior to the date work is to begin. The Contractor shall, in the interim before work is begun, meet at the site with the Engineer or his representative. Authorized representative(s) shall resolve all questions with regard to the layout of equipment to be installed and installation procedures.
- 3.1.3. The Contractor shall be responsible for correcting any defects or malfunctions in the highway crossing protection installation, resulting from poor or faulty installation, workmanship or deviation from specified standards for a period of one (1) year from the date of final acceptance.
- 3.1.4. The Contractor shall be responsible for any loss or damage to equipment of material prior to date of acceptance.

### 3.2. LOCATION OF INSTRUMENT HOUSE

3.2.1. Not Applicable

### 3.3. LOCATION OF SIGNALS

- 3.3.1. Centerline of gate foundations shall be located no closer than 12' from the centerline of track, and preferably 15' from the centerline of track. The gate should be located so as to align with the gate on the opposite side of the street. Gate arm counterweights shall extend no closer than 10' from centerline of track. Centerline of gate foundations shall be located no closer than 5'-3" from inside edge of curb on gate arm side and no closer than 4'-3" from inside edge of curb on back side of gate.

### 3.4. ENGINEERING

3.4.1. The engineering documents shall be provided by the City of Richland, WA. The Contractor shall mark any changes to the plans so as-installed corrections can be made. These marked plans shall be delivered to the Engineer within 10 days of the final installation.

### 3.5. SEQUENCE OF WORK

3.5.1. The Contractor shall coordinate all Work with the road authority, the Railroad, affected utility companies and any other Contractors working in or adjacent to the Project area.

3.5.2. The Contractor is not obligated to perform work in any particular sequence, but should be prepared to explain reasons for work sequencing in any given portion of the Contract.

### 3.6. EXISTING FACILITIES

3.6.1. The Contractor shall conduct signal construction operations to avoid damage to existing ditches, drainage structures, fences, utilities, buildings and other structures (except where designated for removal in the Contract Drawings). All damage to existing facilities shall be repaired by the Contractor at the Contractor's expense.

3.6.2. All utilities are to be located and avoided. If necessary, a hole shall be bored down through the roadway to identify the exact location of any possible conflict.

### 3.7. QUALITY CONTROL AND TESTING

3.7.1. The Contractor shall make and record such tests as may be necessary to demonstrate to the satisfaction of the Engineer or authorized representative that the apparatus, as installed, is in accordance with requirements of these specifications. All tests shall satisfy the requirements of 49 CFR 234 and the component manufacturer.

3.7.2. If, in order to complete the requirements of this contract, it is necessary to effect changes to another signal location, the Contractor shall be responsible to ensure proper operation of that location, including testing and observing train movements.

3.7.3. Grounds – Each circuit shall be kept free of any ground or combination of grounds which shall permit a flow of current equal to or in excess of 75 percent of the release value of any relay or other electromagnetic device in the circuit, except circuits which include any track relay.

3.7.4. Protection of insulated wire – Insulated wire shall be protected from mechanical injury. The insulation shall not be punctured for test purposes. Splices in underground wire shall have insulation resistance at least equal to the wire spliced.

3.7.5. Tagging of wires – Each wire shall be tagged or otherwise so marked that it can be identified at each terminal. Tags and other marks of identification shall be made

of insulating material and so arranged that tags and wires do not interfere with moving parts of apparatus.

- 3.7.6. Insulation resistance tests – Insulation resistance of wires and cables, except wires connected directly to track rails, shall be tested when wires, cables and insulation are dry. Insulation resistance tests shall be made between all conductors and ground, and between conductors in each multiple conductor cable, and between conductors in trunking, when wires or cables are installed. Insulation resistance of wire or cable must be higher than 10 Megohm.
- 3.7.7. Gate arms are to be counterbalanced to conform to manufacturer's specifications.
- 3.7.8. Mast and lane lights shall be aligned to conform to AREMA crossing signal alignment instructions part 3.3.5.
- 3.7.9. Crossing electronics shall be calibrated to manufacturer's specifications in accordance with circuit plan parameters.

### 3.8. PROCEDURES

- 3.8.1. Size and number of conductors to be determined from circuit plans.
- 3.8.2. Cable for gate motors shall be #6 up to 120' cable length and 2 #6 up to 240' cable length.
- 3.8.3. Cable for other circuits for gate mechanisms and bell shall be minimum #14 AWG.
- 3.8.4. All cut ends of conduit shall be reamed and filed to prevent damage to insulation.
- 3.8.5. The length of the cable runs shall provide for ten extra feet at the control house. The conductors shall be taped together as they leave the conduit and be placed in a neat and orderly manner up the wall and suspend from the ceiling, back down and put through the appropriate hole in the backboard.
- 3.8.6. All stranded conductors to be connected in the signal house using insulated ¼-in ring eyelets, crimped with an appropriate tool.
- 3.8.7. All wire terminal posts to be double nutted with washers under and over eyelets.
- 3.8.8. All openings around pipe, conductors and cable wells are to be sealed with concrete grout.
- 3.8.9. All conductors entering the house to be labeled with permanently typed vinyl tags. Labels to conform to circuit plans.

3.8.10. Foundation bolts shall include leveling nuts and conduit shall connect to junction box on signal mast.

3.8.11. Gate mechanism and hardware shall be installed in such a manner that when completed, the gate can be twisted 90 degrees without disconnecting the flex conduit from the base.

3.8.12. All exterior steel hardware and components shall be painted with oil base aluminum color paint applied by brush where needed.

3.8.13. Conduit shall be buried 18 inches or more below and at least 30 inches below the top of ties, under the track.

### 3.9. ROADWAY CONSTRUCTION

3.9.1. The responsibility of repairs to the roadway surface as a result of the new construction must be assumed by the Contractor and warranted for a period of 1 year.

### 3.10. TOOLS

The following tools, or approved equals, are required to be used while performing the work of this Section. Approved equals may be substituted with the prior approval of the Engineer.

3.10.1. Crimping tool adequate to crimp insulated eyelets on #6 and smaller wire, such as HiLine Part No. RC6220.

3.10.2. Crimping tool adequate to crimp "J groove" sleeves and non-insulated eyelets on #6 wire, such as a Nicopress 31-DJ crimping tool.

3.10.3. Crimping tool adequate to crimp insulated, non-insulated and flag terminals on #18 to #10 wire.

3.10.4. Wire labeling machine (see Item 3.7.5 under TESTING).

3.10.5. Megohmmeter insulation tested (see Item 3.7.6 under TESTING).

### 3.11. MATERIAL TO BE LEFT IN THE SIGNAL HOUSE

3.11.1. Safetran No Oxide Grease, Part No. 32-401X.

3.11.2. Safetran Low Temperature Gear Grease, Part No. 32-403X.

## 4. PART 4 - MEASUREMENT AND PAYMENT



#### 4.1. MEASUREMENT

There will be no measurement of crossing gate system installation. The supply and installation of crossing gate system components as required to construct the crossing gate system in accordance with the plans shown in the Contract Drawings shall be considered a single lump sum unit.

#### 4.2. PAYMENT

4.2.1. The contract price for these items shall be payment in full for furnishing all labor, materials, tools, equipment and incidentals, and doing all work necessary to complete the work specified.

4.2.2. Payment for the proper installation of grade crossing gate systems shall be made at the lump sum price for the various items stated on the bid form as follows:

Item No.	Pay Item	Unit
13200-1	Provide and Install Complete Grade Crossing Gate System at Battelle Boulevard, Richland, WA	LS

END OF SECTION